


1 LOCATION OF WATER WELL: Fraction SW 1/4 SE 1/4 NW 1/4 Section Number 28 Township Number T 3S Range Number R 16 E
 County: Brown Distance and direction from nearest town or city street address of well if located within city?

NE corner of 3rd & E Front, Powhattan

2 WATER WELL OWNER: KDHE-BER
 RR#, St. Address, Box # : Forbes Field, Building 740 Board of Agriculture, Division of Water Resources
 City, State, ZIP Code : Topeka, Kansas 66620 Application Number:

3 LOCATE WELL'S LOCATION WITH AN "X" IN SECTION BOX:

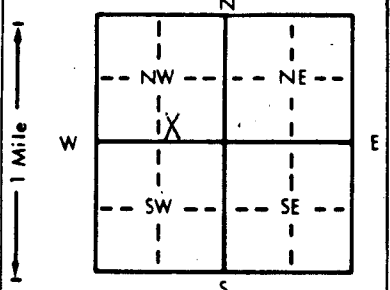

4 DEPTH OF COMPLETED WELL 64.7 ft. ELEVATION:
 Depth(s) Groundwater Encountered 1. 50 ft. 2. ft. 3. 1205.6 ft.
 WELL'S STATIC WATER LEVEL 15.7 ft. below land surface measured on mo/day/yr 1/23/95
 Pump test data: Well water was ft. after hours pumping gpm
 Est. Yield .NA gpm: Well water was ft. after hours pumping gpm
 Bore Hole Diameter 8 in. to 66 ft., and in. to ft.
 WELL WATER TO BE USED AS: 5 Public water supply 8 Air conditioning 11 Injection well
 1 Domestic 3 Feedlot 6 Oil field water supply 9 Dewatering 12 Other (Specify below)
 2 Irrigation 4 Industrial 7 Lawn and garden only 10 Monitoring well
 Was a chemical/bacteriological sample submitted to Department? Yes No X; If yes, mo/day/yr sample was submitted
 Water Well Disinfected? Yes No X

5 TYPE OF BLANK CASING USED: 5 Wrought iron 8 Concrete tile CASING JOINTS: Glued Clamped
 1 Steel 3 RMP (SR) 6 Asbestos-Cement 9 Other (specify below) Welded
 2 PVC 4 ABS 7 Fiberglass Threaded X
 Blank casing diameter 2 in. to 54.7 ft., Dia in. to ft., Dia in. to ft.
 Casing height above land surface 3.5 in., weight lbs./ft. Wall thickness or gauge No. Sch. 40
 TYPE OF SCREEN OR PERFORATION MATERIAL: 7 PVC 10 Asbestos-cement
 1 Steel 3 Stainless steel 5 Fiberglass 8 RMP (SR) 11 Other (specify)
 2 Brass 4 Galvanized steel 6 Concrete tile 9 ABS 12 None used (open hole)
 SCREEN OR PERFORATION OPENINGS ARE: 5 Gauzed wrapped 8 Saw cut 11 None (open hole)
 1 Continuous slot 3 Mill slot 6 Wire wrapped 9 Drilled holes
 2 Louvered shutter 4 Key punched 7 Torch cut 10 Other (specify)
 SCREEN-PERFORATED INTERVALS: From 54.7 ft. to 64.7 ft., From ft. to ft.
 From ft. to ft., From ft. to ft.
 GRAVEL PACK INTERVALS: From 52 ft. to 66 ft., From ft. to ft.
 From ft. to ft., From ft. to ft.

6 GROUT MATERIAL: 1 Neat cement 2 Cement grout 3 Bentonite 4 Other
 Grout Intervals: From 0 ft. to 48.5 ft., From 48.5 ft. to 52 ft., From ft. to ft.
 What is the nearest source of possible contamination: 10 Livestock pens 14 Abandoned water well
 1 Septic tank 4 Lateral lines 7 Pit privy 11 Fuel storage 15 Oil well/Gas well
 2 Sewer lines 5 Cess pool 8 Sewage lagoon 12 Fertilizer storage 16 Other (specify below)
 3 Watertight sewer lines 6 Seepage pit 9 Feedyard 13 Insecticide storage Grain Storage

Direction from well? <u>SW</u>		LITHOLOGIC LOG		How many feet? <u>150</u>		PLUGGING INTERVALS	
FROM	TO			FROM	TO		
0	2	Clay, Dark Brown				MW4	
2	4.5	Clay, Dark Brown				GeoCore # 113	Flush-mount Cover
4.5	7	Clay, Light Gray				KDHE #	Tag # 00117052
7	35	Clay, Red Brown					
35	40	Clay, Light Gray					
40	48	Clay, Red Brown					
48	55	Clay, Light Gray					
55	59	Clay, Light Gray					
59	64.5	Sandy Clay, Light Gray					
64.5	66	Shale, Light Gray					

7 CONTRACTOR'S OR LANDOWNER'S CERTIFICATION: This water well was (1) constructed, (2) reconstructed, or (3) plugged under my jurisdiction and was completed on (mo/day/year) 1/23/95 and this record is true to the best of my knowledge and belief. Kansas Water Well Contractor's License No. 527 This Water Well Record was completed on (mo/day/yr) 2/15/95 under the business name of GeoCore Services, Inc. by (signature) Dale Roll

INSTRUCTIONS: Use typewriter or ball point pen. PLEASE PRESS FIRMLY and PRINT clearly. Please fill in blanks, underline or circle the correct answers. Send top three copies to Kansas Department of Health and Environment, Bureau of Water, Topeka, Kansas 66620-0001. Telephone: 913-296-5545. Send one to WATER WELL OWNER and retain one for your records.