

WATER WELL RECORD Form WWC-5 KSA 82a-1212

1 LOCATION OF WATER WELL: County: Brown	Fraction SE 1/4 SW 1/4 NW 1/4	Section Number 28	Township Number T 3S	Range Number R 16 E 5W
---	---	-----------------------------	--------------------------------	----------------------------------

Distance and direction from nearest town or city street address of well if located within city?

N side of 3rd St. 80' W of Commercial, Powhattan

2 WATER WELL OWNER: RR#, St. Address, Box # : City, State, ZIP Code :	KDHE-BER Forbes Field, Building 740 Topeka, Kansas 66620	Board of Agriculture, Division of Water Resources Application Number:
---	---	--

3 LOCATE WELL'S LOCATION WITH AN "X" IN SECTION BOX:

4 DEPTH OF COMPLETED WELL... **68** ft. ELEVATION:

Depth(s) Groundwater Encountered 1. **55** ft. 2. ft. 3. **1205.8** ft.

WELL'S STATIC WATER LEVEL **17.9** ft. below land surface measured on mo/day/yr **1/23/95**

Pump test data: Well water was ft. after hours pumping gpm

Est. Yield **.NA** gpm: Well water was ft. after hours pumping gpm

Bore Hole Diameter **8** in. to **68** ft., and in. to ft.


WELL WATER TO BE USED AS: 5 Public water supply 8 Air conditioning 11 Injection well

1 Domestic 3 Feedlot 6 Oil field water supply **9 Dewatering** 12 Other (Specify below)

2 Irrigation 4 Industrial 7 Lawn and garden only **10 Monitoring well**

Was a chemical/bacteriological sample submitted to Department? Yes.....No.....**X**.....; If yes, mo/day/yr sample was submitted

Water Well Disinfected? Yes No **X**

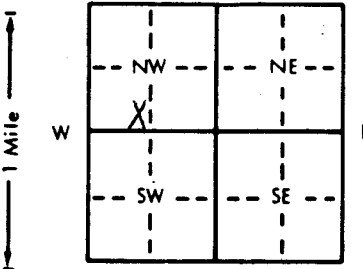

5 TYPE OF BLANK CASING USED:

1 Steel	3 RMP (SR)	5 Wrought iron	8 Concrete tile	CASING JOINTS: Glued Clamped
2 PVC	4 ABS	6 Asbestos-Cement	9 Other (specify below)	Welded
Blank casing diameter 2 in. to 58 ft., Dia in. to ft., Dia in. to ft.	7 Fiberglass	Threaded... X		
Casing height above land surface 4.3 in., weight lbs./ft. Wall thickness or gauge No. Sch. 40				

TYPE OF SCREEN OR PERFORATION MATERIAL:

1 Steel	3 Stainless steel	5 Fiberglass	7 PVC	10 Asbestos-cement
2 Brass	4 Galvanized steel	6 Concrete tile	8 RMP (SR)	11 Other (specify)
12 None used (open hole)				

SCREEN OR PERFORATION OPENINGS ARE:

1 Continuous slot	3 Mill slot	5 Gauzed wrapped	8 Saw cut	11 None (open hole)
2 Louvered shutter	4 Key punched	6 Wire wrapped	9 Drilled holes	
7 Torch cut 10 Other (specify)				

SCREEN-PERFORATED INTERVALS: From **58** ft. to **68** ft., From ft. to ft.

GRAVEL PACK INTERVALS: From **56** ft. to **68** ft., From ft. to ft.

6 GROUT MATERIAL: 1 Neat cement **2 Cement grout** **3 Bentonite** 4 Other

Grout intervals: From **0** ft. to **52** ft., From **52** ft. to **56** ft., From ft. to ft.

What is the nearest source of possible contamination:

1 Septic tank	4 Lateral lines	7 Pit privy	10 Livestock pens	14 Abandoned water well
2 Sewer lines	5 Cess pool	8 Sewage lagoon	11 Fuel storage	15 Oil well/Gas well
3 Watertight sewer lines	6 Seepage pit	9 Feedyard	12 Fertilizer storage	16 Other (specify below)
				Grain Storage

Direction from well? **SE** How many feet? **200**

FROM	TO	LITHOLOGIC LOG	FROM	TO	PLUGGING INTERVALS
0	4	Clay, Dark Brown			MW5
4	7	Clay, Gray			GeoCore # 113 Flush-mount Cover
7	20	Clay, Light Red Brown			KDHE # Tag # 00117076
20	40	Clay, Light Red Brown			
40	50	Clay, Light Gray			
50	55	Clay, Red Brown			
55	60	Clay, Red Brown			
60	65	Sand, Red Brown			
65	65.7	Clay, Red Brown			
65.7	67.9	Reworked Shale, Gray			
67.9	68	Shale, Light Gray			

7 CONTRACTOR'S OR LANDOWNER'S CERTIFICATION: This water well was **1** constructed, (2) reconstructed, or (3) plugged under my jurisdiction and was completed on (mo/day/year) **1/23/95** and this record is true to the best of my knowledge and belief. Kansas Water Well Contractor's License No. **527** This Water Well Record was completed on (mo/day/yr) **2/15/95** under the business name of **GeoCore Services, Inc.** by (signature) *Del Roll*

INSTRUCTIONS: Use typewriter or ball point pen. PLEASE PRESS FIRMLY and PRINT clearly. Please fill in blanks, underline or circle the correct answers. Send top three copies to Kansas Department of Health and Environment, Bureau of Water, Topeka, Kansas 66620-0001. Telephone: 913-296-5545. Send one to WATER WELL OWNER and retain one for your records.