


1 LOCATION OF WATER WELL: County: **Brown** Fraction: **NW 1/4 NE 1/4 SW 1/4** Section Number: **28** Township Number: **T 3S** Range Number: **R 16 E**

Distance and direction from nearest town or city street address of well if located within city?
SW corner of 2nd St. and W Front St.

2 WATER WELL OWNER: **KDHE-BER**
 RR#, St. Address, Box # : **Forbes Field, Building 740** Board of Agriculture, Division of Water Resources
 City, State, ZIP Code : **Topeka, Kansas 66620** Application Number:

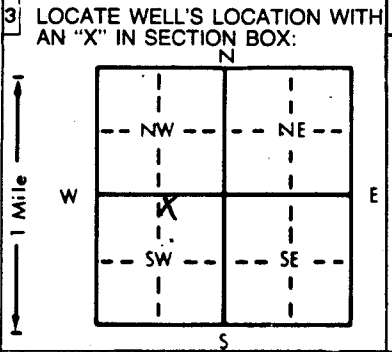

4 DEPTH OF COMPLETED WELL: **66** ft. ELEVATION: **1205.2** ft.
 WELL'S STATIC WATER LEVEL: **13.5** ft. below land surface measured on **mo/day/yr** **1/23/95**
 Pump test data: Well water was **NA** ft. after **NA** hours pumping **NA** gpm
 Est. Yield **NA** gpm: Well water was **NA** ft. after **NA** hours pumping **NA** gpm
 Bore Hole Diameter: **8** in. to **69** ft., and **NA** in. to **NA** ft.
 WELL WATER TO BE USED AS:
 5 Public water supply 8 Air conditioning 11 Injection well
 1 Domestic 3 Feedlot 6 Oil field water supply 9 **Dewatering** 12 Other (Specify below)
 2 Irrigation 4 Industrial 7 Lawn and garden only 10 **Monitoring well**
 Was a chemical/bacteriological sample submitted to Department? Yes **NA** No **X**; If yes, mo/day/yr sample was submitted
 Water Well Disinfected? Yes **NA** No **X**

5 TYPE OF BLANK CASING USED:
 1 **Steel** 3 RMP (SR) 5 Wrought iron 8 Concrete tile CASING JOINTS: Glued **NA** Clamped **NA**
 2 **PVC** 4 ABS 6 Asbestos-Cement 9 Other (specify below) Welded **NA**
 Blank casing diameter: **4** in. to **56** ft., Dia **NA** in. to **NA** ft., Dia **NA** in. to **NA** ft.
 Casing height above land surface: **-3.2** in., weight **NA** lbs./ft. Wall thickness or gauge No. **Sch. 40**
 TYPE OF SCREEN OR PERFORATION MATERIAL:
 1 Steel 3 Stainless steel 5 Fiberglass 7 **PVC** 10 Asbestos-cement
 2 Brass 4 Galvanized steel 6 Concrete tile 8 RMP (SR) 11 Other (specify) **NA**
 12 None used (open hole)
 SCREEN OR PERFORATION OPENINGS ARE:
 1 Continuous slot 2 **Mill slot** 3 **Mill slot** 4 Key punched 5 Gauzed wrapped 6 Wire wrapped 7 Torch cut 8 Saw cut 9 Drilled holes 10 Other (specify) **NA**
 11 None (open hole)
 SCREEN-PERFORATED INTERVALS: From **56** ft. to **66** ft., From **NA** ft. to **NA** ft., From **NA** ft. to **NA** ft.
 GRAVEL PACK INTERVALS: From **52** ft. to **69** ft., From **NA** ft. to **NA** ft., From **NA** ft. to **NA** ft.

6 GROUT MATERIAL: 1 Neat cement 2 **Cement grout** 3 **Bentonite** 4 Other **NA**
 Grout Intervals: From **0** ft. to **40** ft., From **40** ft. to **52** ft., From **NA** ft. to **NA** ft.
 What is the nearest source of possible contamination:
 1 Septic tank 2 Sewer lines 3 Watertight sewer lines 4 Lateral lines 5 Cess pool 6 Seepage pit 7 Pit privy 8 Sewage lagoon 9 Feedyard 10 Livestock pens 11 Fuel storage 12 Fertilizer storage 13 Insecticide storage 14 Abandoned water well 15 Oil well/Gas well 16 **Other (specify below) Grain Storage**

Direction from well? **E** How many feet? **300**

FROM	TO	LITHOLOGIC LOG	FROM	TO	PLUGGING INTERVALS
0	5	Clay, Dark Brown			MW10
5	11	Clay, Light Gray Brown			GeoCore # 113
11	34	Clay, Medium Red Brown			Flush-mount Cover
34	61	Clay, Light to Medium Gray Brown			KDHE #
61	67	Clay, Green Gray			Tag # 00117014
67	69	Shale, Light to Medium Gray Green			

7 CONTRACTOR'S OR LANDOWNER'S CERTIFICATION: This water well was **(1)** constructed, **(2)** reconstructed, or **(3)** plugged under my jurisdiction and was completed on (mo/day/year) **1/23/95** and this record is true to the best of my knowledge and belief. Kansas Water Well Contractor's License No. **527** This Water Well Record was completed on (mo/day/yr) **2/15/95** under the business name of **GeoCore Services, Inc.** by (signature) **[Signature]**

* INSTRUCTIONS: Use typewriter or ball point pen. PLEASE PRESS FIRMLY and PRINT clearly. Please fill in blanks, underline or circle the correct answers. Send top three copies to Kansas Department of Health and Environment, Bureau of Water, Topeka, Kansas 66620-0001. Telephone: 913-296-5545. Send one to WATER WELL OWNER and retain one for your records.