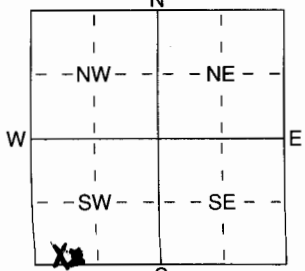


1 LOCATION OF WATER WELL: Fraction SW 1/4 SW 1/4 SW 1/4 Section Number 26 Township Number T 3 S Range Number R 17 EW
 County: Brown

Distance and direction from nearest town or city street address of well if located within city?
From City of Willis .75 mi. East, 2 mi. North, .2 mi. East + 75' North approx.

2 WATER WELL OWNER: Roger Toilefson
 RR#, St. Address, Box # : 1040 2nd AV East Board of Agriculture, Division of Water Resources
 City, State, ZIP Code : Horton, KS 66439 Application Number:

3 LOCATE WELL'S LOCATION WITH AN "X" IN SECTION BOX:

 4 DEPTH OF COMPLETED WELL 81 ft. ELEVATION:
 Depth(s) Groundwater Encountered 1 12-18 ft. 2 ft. 3 ft.
 WELL'S STATIC WATER LEVEL 11.5 ft. below land surface measured on mo/day/yr 6-21-2006
 Pump test data: Well water was ft. after hours pumping gpm
 Est. Yield 2 gpm: Well water was ft. after hours pumping gpm
 WELL WATER TO BE USED AS: 5 Public water supply 8 Air conditioning 11 Injection well
1 Domestic 3 Feedlot 6 Oil field water supply 9 Dewatering 12 Other (Specify below)
 2 Irrigation 4 Industrial 7 Domestic (lawn & garden) 10 Monitoring well
 Was a chemical/bacteriological sample submitted to Department? Yes No X; If yes, mo/day/yr sample was submitted
 Water Well Disinfected? Yes No

5 TYPE OF BLANK CASING USED: 5 Wrought iron 8 Concrete tile CASING JOINTS: Glued X Clamped
 1 Steel 3 RMP (SR) 6 Asbestos-Cement 9 Other (specify below) Welded
2 PVC 4 ABS 7 Fiberglass Threaded
 Blank casing diameter 5 in. to 0-14 ft., Dia 5 in. to 26-76 ft., Dia in. to ft.
 Casing height above land surface 23 in., weight 2.87 lbs./ft. Wall thickness or gauge No. SDR 21
 TYPE OF SCREEN OR PERFORATION MATERIAL: 7 PVC 10 Asbestos-Cement
 1 Steel 3 Stainless Steel 5 Fiberglass 8 RMP (SR) 11 Other (Specify)
 2 Brass 4 Galvanized Steel 6 Concrete tile 9 ABS 12 None used (open hole)
 SCREEN OR PERFORATION OPENINGS ARE: 5 Gauzed wrapped 8 Saw cut 11 None (open hole)
 1 Continuous slot 3 Mill slot 6 Wire wrapped 9 Drilled holes
 2 Louvered shutter 4 Key punched 7 Torch cut 10 Other (specify) ft.
 SCREEN-PERFORATED INTERVALS: From 14' ft. to 26' ft., From 76' ft. to 81' ft.
 From ft. to ft., From ft. to ft.
 GRAVEL PACK INTERVALS: From 13' ft. to 81' ft., From ft. to ft.
 From ft. to ft., From ft. to ft.

6 GROUT MATERIAL: 1 Neat cement 2 Cement grout 3 Bentonite 4 Other
 Grout Intervals: From 0 ft. to 13 ft., From ft. to ft.
 What is the nearest source of possible contamination: 10 Livestock pens 14 Abandoned water well
 1 Septic tank 4 Lateral lines 7 Pit privy 11 Fuel storage 15 Oil well/Gas well
 2 Sewer lines 5 Cess pool 8 Sewage lagoon 12 Fertilizer storage 16 Other (specify below)
 3 Watertight sewer lines 6 Seepage pit 9 Feedyard 13 Insecticide storage Farm Field
 Direction from well? North How many feet? 130'

FROM	TO	LITHOLOGIC LOG	FROM	TO	PLUGGING INTERVALS
0	1	Topsoil	61	62	Grey Limestone
3	5	Brown Clay	62	63.5	Grey Limestone - Cherry
5	8	Brown Sandy Clay	63.5	72	Grey Shale
8	10	Brown Coarse Sand	72	77	Grey Sandy Shale
10	12	Sandy Grey Sandy Clay	77	77.5	Grey Limestone
12	14	Brown Coarse Sand	77.5	79.5	Grey Shale
15	16	Brown Fine/Coarse Sand	79.5	81.5	Grey Limestone / Lime Shale
16	18	Brown/Grey Coarse Sand	81.5	81.5	Rock
18	20	Grey Clay			
20	22	Grey Shale			
22	25	Grey Sandy Shale			
25	27.5	Grey Limestone			
27.5	30	Blue Sandy Clay/Shale			
30	61	Grey Shale			

Shallow grout permission by Don Taylor on 6-19-2006

7 CONTRACTOR'S OR LANDOWNER'S CERTIFICATION: This water well was (1) constructed, (2) reconstructed, or (3) plugged under my jurisdiction and was completed on (mo/day/year) 6-20-2006 and this record is true to the best of my knowledge and belief. Kansas Water Well Contractor's Licence No 739 This Water Well Record was completed on (mo/day/yr) 7-3-2006 under the business name of Rork Drilling by (signature) Mike Rork