

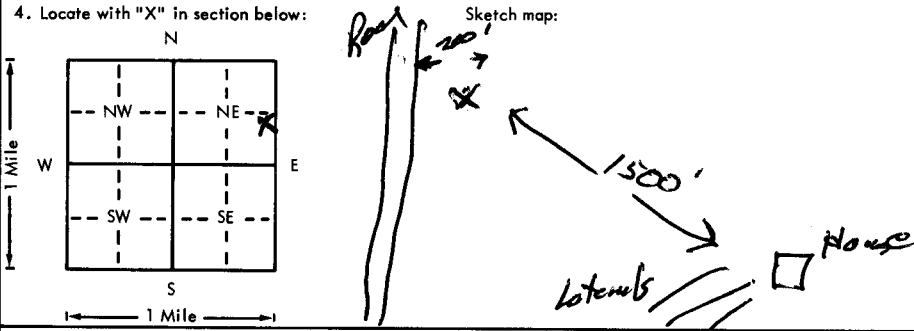
37

USE TYPEWRITER OR BALL
POINT PEN-PRESS FIRMLY,
PRINT CLEARLY.

WATER WELL RECORD
KSA 82a-1201-1215

ADA

Kansas Department of Health and
Environment-Division of Environment
(Water well Contractors)
Topeka, Kansas 66620

1. Location of well:	County <u>Brown</u>	Fraction <u>NE 1/4 SE 1/4 NE 1/4</u>	Section number <u>2</u>	Township number T <u>3</u> S	Range number R <u>17</u> E <u>W</u>																														
2. Distance and direction from nearest town or city: <u>3 E 2 1/2 S</u>			3. Owner of well: <u>Kieth Cummings</u> R.R. or street: <u>RR #2</u> City, state, zip code: <u>Hickman, NE 68341</u>																																
4. Locate with "X" in section below: 			6. Bore hole dia. <u>8</u> in. Completion date <u>5-2-77</u> Well depth <u>80</u> ft.																																
5. Type and color of material			7. <input checked="" type="checkbox"/> Cable tool <input checked="" type="checkbox"/> Rotary <input type="checkbox"/> Driven <input type="checkbox"/> Dug <input type="checkbox"/> Hollow rod <input type="checkbox"/> Jetted <input type="checkbox"/> Bored <input type="checkbox"/> Reverse rotary																																
<table border="1"> <thead> <tr> <th></th> <th>From</th> <th>To</th> </tr> </thead> <tbody> <tr><td>Top Soil</td><td>0</td><td>4</td></tr> <tr><td>Brown Clay loam</td><td>4</td><td>8</td></tr> <tr><td>Brown Clay</td><td>8</td><td>15</td></tr> <tr><td>Gray Clay</td><td>15</td><td>22</td></tr> <tr><td>Brown Silty Clay</td><td>22</td><td>31</td></tr> <tr><td>Gray Clay</td><td>31</td><td>51</td></tr> <tr><td>Gray Sandy Clay</td><td>51</td><td>54</td></tr> <tr><td>Gray Shale</td><td>54</td><td>61</td></tr> <tr><td>Gray Limestone</td><td>61</td><td>63</td></tr> </tbody> </table>				From	To	Top Soil	0	4	Brown Clay loam	4	8	Brown Clay	8	15	Gray Clay	15	22	Brown Silty Clay	22	31	Gray Clay	31	51	Gray Sandy Clay	51	54	Gray Shale	54	61	Gray Limestone	61	63	8. Use: <input checked="" type="checkbox"/> Domestic <input type="checkbox"/> Public supply <input type="checkbox"/> Industry <input type="checkbox"/> Irrigation <input type="checkbox"/> Air conditioning <input type="checkbox"/> Stock <input type="checkbox"/> Lawn <input type="checkbox"/> Oil field water <input type="checkbox"/> Other		
			9. Casing: Material <u>PVC</u> Height: <u>Above</u> or below Threaded <input type="checkbox"/> Welded <input type="checkbox"/> Surface <u>24</u> in. RMP <u>PVC</u> Weight <u>2.74</u> lbs./ft. Dia. <u>5</u> in. to <u>80</u> ft. depth Wall Thickness: inches or Dia. <u>5</u> in. to <u>80</u> ft. depth gage No. <u>258</u>																																
			10. Screen: Manufacturer's name <u>Dumco</u> Type <u>PVC</u> Dia. <u>5"</u> Slot/gauze <u>.020</u> Length <u>15</u> Set between <u>45</u> ft. and <u>60</u> ft. Gravel pack? <u>yes</u> Size range of material <u>20-30</u>																																
			11. Static water level: <u>45</u> ft. below land surface Date <u>5-2-77</u> mo./day/yr.																																
			12. Pumping level below land surfaces: <u>air test</u> ft. after hrs. pumping g.p.m. ft. after hrs. pumping g.p.m. Estimated maximum yield g.p.m.																																
			13. Water sample submitted: <u>yes</u> No Date																																
			14. Well head completion: <u>Cap top</u> Pitless adapter <u>24</u> inches above grade																																
			15. Well grouted? <u>yes</u> With: <input checked="" type="checkbox"/> Neat cement <input type="checkbox"/> Bentonite <input type="checkbox"/> Concrete Depth: From <u>5</u> ft. to <u>15</u> ft.																																
			16. Nearest source of possible contamination: ft. <u>1500</u> Direction <u>NW</u> Type <u>lotenb</u> Well disinfected upon completion? <input checked="" type="checkbox"/> Yes <input type="checkbox"/> No																																
			17. Pump: <input checked="" type="checkbox"/> Not installed Manufacturer's name _____ Model number _____ HP _____ Volts _____ Length of drop pipe _____ ft. capacity _____ g.p.m. Type: <input type="checkbox"/> Submersible <input type="checkbox"/> Turbine <input type="checkbox"/> Jet <input type="checkbox"/> Reciprocating <input type="checkbox"/> Centrifugal <input type="checkbox"/> Other																																
18. Elevation: <u>1030</u> Topography: <u>1000 RM</u> <input checked="" type="checkbox"/> Hill <input type="checkbox"/> Slope <input type="checkbox"/> Upland <input checked="" type="checkbox"/> Valley			19. Remarks: <u>owner will pour concrete slab around well</u>																																
20. Water well contractor's certification: This well was drilled under my jurisdiction and this report is true to the best of my knowledge and belief. <u>Strader Delg Co Inc</u> 182 Business name License No. Address <u>RT 1 Holtan, KS</u> Signed <u>Dale Ashum</u> Date <u>5-3-77</u> Authorized representative																																			

Forward the white, blue and pink copies to the Department of Health and Environment

Form WWC-5

BR = 976 $\frac{1}{2}$ = 985