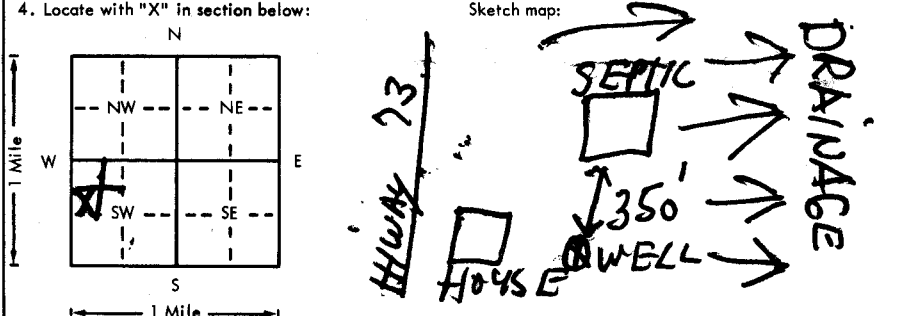


USE TYPEWRITER OR BALL
POINT PEN-PRESS FIRMLY,
PRINT CLEARLY.

WATER WELL RECORD
KSA 82a-1201-1215

Kansas Department of Health and
Environment-Division of Environment
(Water well Contractors)
Topeka, Kansas 66620

CBC

| | | | | | |
|---|------------------------|--|-----------------------------|---------------------------------|-------------------------------|
| 1. Location of well: | County <u>Brown</u> | Fraction <u>SW 1/4 NW 1/4 SW 1/4</u> | Section number <u>11</u> | Township number <u>T 3 S</u> | Range number <u>R 17 E</u> |
| 2. Distance and direction from nearest town or city: <u>2 miles south of Hiawatha, Kansas</u> Street address of well location if in city: | | 3. Owner of well: <u>Roger Gatz</u> R.R. or street: <u>R. 2</u> City, state, zip code: <u>Hiawatha, Kansas 66434</u> | | | |
| 4. Locate with "X" in section below:  | | 6. Bore hole dia. <u>12</u> in. Completion date <u>7/14/82</u> Well depth <u>70</u> ft. Bore hole <u>50"</u> to <u>11'</u> | | | |
| 5. Type and color of material | | 7. <input type="checkbox"/> Cable tool <input type="checkbox"/> Rotary <input type="checkbox"/> Driven <input type="checkbox"/> Dug <input type="checkbox"/> Hollow rod <input type="checkbox"/> Jetted <input checked="" type="checkbox"/> Bored <input type="checkbox"/> Reverse rotary | | | |
| Light brown windblown | | 8. Use: <input checked="" type="checkbox"/> Domestic <input type="checkbox"/> Public supply <input type="checkbox"/> Industry <input type="checkbox"/> Irrigation <input type="checkbox"/> Air conditioning <input type="checkbox"/> Stock <input type="checkbox"/> Lawn <input type="checkbox"/> Oil field water <input type="checkbox"/> Other | | | |
| Same - with very little change | | 9. Casing: Material <u>Concrete</u> Height: <u>5</u> ft. or below Threaded <input type="checkbox"/> Welded <input type="checkbox"/> Surface <u>2 1/2</u> in. RMP <input type="checkbox"/> PVC <input type="checkbox"/> Weight <u>320</u> lbs./ft. Dia. <u>36</u> in. to <u>70</u> ft. depth Wall Thickness: inches or Dia. <u>36</u> in. to <u>70</u> ft. depth gage No. <u>3 in.</u> | | | |
| Soft windblown | | 10. Screen: Manufacturer's name _____ Type _____ Dia. _____ Slot/gauze _____ Length _____ Set between _____ ft. and _____ ft. _____ ft. and _____ ft. Gravel pack? _____ Size range of material _____ | | | |
| Coarse sand - productive | | 11. Static water level: _____ mo./day/yr. <u>48</u> ft. below land surface Date <u>7/14/82</u> | | | |
| Very light yellow in color | | 12. Pumping level below land surfaces: <u>54</u> ft. after <u>1</u> hrs. pumping <u>20</u> g.p.m. <u>60</u> ft. after <u>2</u> hrs. pumping <u>20</u> g.p.m. Estimated maximum yield <u>6-8</u> g.p.m. | | | |
| Hard yellow clay | | 13. Water sample submitted: _____ mo./day/yr. Yes <input checked="" type="checkbox"/> No <input type="checkbox"/> Date _____ | | | |
| Medium hard - blue clay | | 14. Well head completion: _____ Pitless adapter _____ Inches above grade | | | |
| (Use a second sheet if needed) | | 15. Well grouted? <input checked="" type="checkbox"/> With: <input checked="" type="checkbox"/> Neat cement <input type="checkbox"/> Bentonite <input type="checkbox"/> Concrete Depth: From <u>0</u> ft. to <u>11</u> ft. | | | |
| 18. Elevation: <u>1122</u> Topography: <u>fn</u> <input checked="" type="checkbox"/> Hill <input type="checkbox"/> Slope <input type="checkbox"/> Upland <input type="checkbox"/> Valley | | 16. Nearest source of possible contamination: ft. <u>350</u> Direction <u>North</u> Type <u>septic</u> Well disinfected upon completion? <input checked="" type="checkbox"/> Yes <input type="checkbox"/> No | | | |
| 19. Remarks: | | 17. Pump: <input checked="" type="checkbox"/> Not installed Manufacturer's name _____ Model number _____ HP _____ Volts _____ Length of drop pipe _____ ft. capacity _____ g.p.m. Type: <input type="checkbox"/> Submersible <input type="checkbox"/> Turbine <input type="checkbox"/> Jet <input type="checkbox"/> Reciprocating <input type="checkbox"/> Centrifugal <input type="checkbox"/> Other | | | |
| | | 20. Water well contractor's certification: This well was drilled under my jurisdiction and this report is true to the best of my knowledge and belief. <u>Popplewell Well Boring 320</u> Business name _____ License No. _____ Address: <u>Amity, Mo. 64122</u> Signed: <u>Don Popplewell</u> Date <u>8/3/82</u> Authorized representative | | | |