

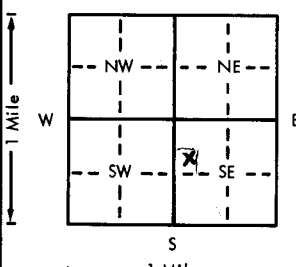
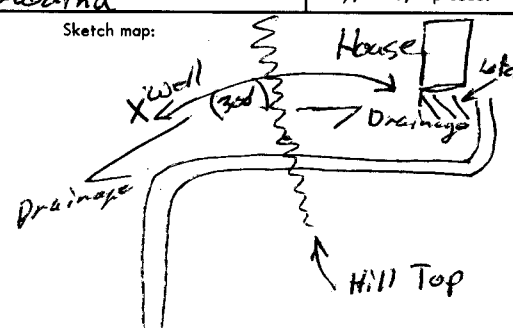
38

* this was
rechecked Run

USE TYPEWRITER OR BALL
POINT PEN-PRESS FIRMLY,
PRINT CLEARLY.

WATER WELL RECORD
KSA 82a-1201-1215

Kansas Department of Health and
Environment-Division of Environment
(Water well Contractors)
Topeka, Kansas 66620

1. Location of well:		County <u>Brown</u>	Fraction <u>SW</u> <u>NE</u> <u>1/4 NW 1/4</u> <u>1/4</u>	Section number <u>4</u>	Township number T <u>3</u> S	Range number R <u>17</u> <u>EW</u>
2. Distance and direction from nearest town or city: <u>2 1/2 E 1/2 N</u> RR # <u>2</u> Street address of well location if in city: <u>Hawatha</u>			3. Owner of well: <u>Bob Mathewson</u> R.R. or street: <u>1227 N. 69th</u> City, state, zip code: <u>K.C. KS 66102</u>			
4. Locate with "X" in section below:		Sketch map:		6. Bore hole dia. <u>8</u> in. Completion date <u>5-24-77</u> Well depth <u>100</u> ft.		
				7. Cable tool <input checked="" type="checkbox"/> Rotary <input type="checkbox"/> Driven <input type="checkbox"/> Dug <input type="checkbox"/> Hollow rod <input type="checkbox"/> Jetted <input type="checkbox"/> Bored <input type="checkbox"/> Reverse rotary		
5. Type and color of material				8. Use: <input checked="" type="checkbox"/> Domestic <input type="checkbox"/> Public supply <input type="checkbox"/> Industry <input type="checkbox"/> Irrigation <input type="checkbox"/> Air conditioning <input type="checkbox"/> Stock <input type="checkbox"/> Lawn <input type="checkbox"/> Oil field water <input type="checkbox"/> Other		
				9. Casing: Material <u>PVC</u> Height <u>(Above or below)</u> Threaded <input type="checkbox"/> Welded <input type="checkbox"/> Surface <u>24</u> in. RMP <u>PVC</u> <u>GIUE</u> Weight <u>2.74</u> lbs./ft. Dia. <u>5</u> in. to <u>100</u> ft. depth Wall Thickness: inches or Dia. <u>5</u> in. to <u>100</u> ft. depth gage No. <u>258</u>		
				10. Screen: Manufacturer's name <u>PUMPCO</u> Type <u>PVC</u> Dia. <u>5"</u> Slot/gauze <u>020</u> Length <u>30'</u> Set between <u>17</u> ft. and <u>47</u> ft. Gravel pack? <u>YES</u> Size range of material <u>030/080</u>		
				11. Static water level: _____ mo./day/yr. <u>22</u> ft. below land surface Date <u>5-24-77</u>		
				12. Pumping level below land surfaces: <u>1 1/2</u> ft. _____ ft. after _____ hrs. pumping _____ g.p.m. _____ ft. after _____ hrs. pumping _____ g.p.m. Estimated maximum yield <u>1/2</u> g.p.m.		
				13. Water sample submitted: _____ mo./day/yr. Yes <input checked="" type="checkbox"/> No <input type="checkbox"/> Date _____		
				14. Well head completion: <u>TOP COP</u> <input type="checkbox"/> Pitless adapter <u>24</u> inches above grade		
				15. Well grouted? <u>YES</u> With: <input checked="" type="checkbox"/> Neat cement <input type="checkbox"/> Bentonite <input type="checkbox"/> Concrete Depth: From <u>0</u> ft. to <u>10</u> ft.		
				16. Nearest source of possible contamination: ft. <u>300</u> Direction <u>SE</u> Type <u>laterals</u> Well disinfected upon completion? <input checked="" type="checkbox"/> Yes <input type="checkbox"/> No		
				17. Pump: <input checked="" type="checkbox"/> Not installed Manufacturer's name _____ Model number _____ HP _____ Volts _____ Length of drop pipe _____ ft. capacity _____ g.p.m. Type: <input type="checkbox"/> Submersible <input type="checkbox"/> Turbine <input type="checkbox"/> Jet <input type="checkbox"/> Reciprocating <input type="checkbox"/> Centrifugal <input type="checkbox"/> Other		
18. Elevation: <u>1080</u> Topography: <u>pl</u> <input checked="" type="checkbox"/> Hill <input type="checkbox"/> Slope <input type="checkbox"/> Upland <input type="checkbox"/> Valley		19. Remarks: <u>owner will construct well</u> <u>slab,</u>		20. Water well contractor's certification: This well was drilled under my jurisdiction and this report is true to the best of my knowledge and belief. <u>STRADER DRILL CO. 182</u> Business name License No. Address <u>RT 1 HOLTON, KS</u> Signed <u>Gary Johnson</u> Date <u>5-25-77</u> Authorized representative		

BR = 1034
= 1058

1
3
17
4
SE NW SE
1/4 1/4 1/4