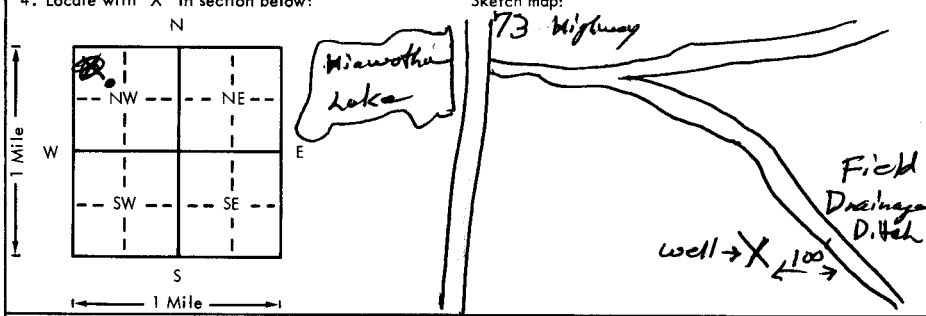


USE TYPEWRITER OR BALL  
POINT PEN-PRESS FIRMLY,  
PRINT CLEARLY.

WATER WELL RECORD  
KSA 82a-1201-1215

Kansas Department of Health and  
Environment-Division of Environment  
(Water well Contractors)  
Topeka, Kansas 66620

1. Location of well:		County <b>Brown</b>	Fraction <b>SE 1/4 NW 1/4 NW 1/4</b>	Section number <b>4</b>	Township number <b>T 3 S</b>	Range number <b>R 17 E/W</b>
2. Distance and direction from nearest town or city: <b>1 S,</b>			3. Owner of well: <b>Alvin Dickenson</b> R.R. or street: <b>RR 1</b> City, state, zip code: <b>Hiawatha, Ks. 66434</b>			
Street address of well location if in city: <b>Hiawatha, Ks.</b>						
4. Locate with "X" in section below:			Sketch map:			
						
5. Type and color of material			From	To	6. Bore hole dia. <b>10</b> in. Completion date <b>6-19-79</b> Well depth <b>80</b> ft.	
<b>Brown Clay</b>			<b>0</b>	<b>10</b>	7. <input checked="" type="checkbox"/> Cable tool <input checked="" type="checkbox"/> Rotary <input type="checkbox"/> Driven <input type="checkbox"/> Dug <input type="checkbox"/> Hollow rod <input type="checkbox"/> Jetted <input type="checkbox"/> Bored <input type="checkbox"/> Reverse rotary	
<b>Yellow Sandy Clay</b>			<b>10</b>	<b>15</b>	8. Use: <input checked="" type="checkbox"/> Domestic <input type="checkbox"/> Public supply <input type="checkbox"/> Industry <input type="checkbox"/> Irrigation <input type="checkbox"/> Air conditioning <input type="checkbox"/> Stock <input type="checkbox"/> Lawn <input type="checkbox"/> Oil field water <input type="checkbox"/> Other	
<b>Yell Coarse Sand to Mod. Gravel</b>			<b>15</b>	<b>16</b>	9. Casing: Material <b>PVC</b> Height: <b>Above</b> or below Threaded <input type="checkbox"/> Welded <input type="checkbox"/> Surface <b>24</b> in. RMP <b>PVC</b> <b>Glue</b> Weight <b>2.74</b> lbs./ft. Dia. <b>5</b> in. to <b>80</b> ft. depth Wall Thickness: inches or Dia. <b>5</b> in. to <b>80</b> ft. depth gage No. <b>1258</b>	
<b>Yell Clay</b>			<b>16</b>	<b>35</b>	10. Screen: Manufacturer's name <b>Pumpco MPI</b> Type <b>PVC</b> Dia. <b>5</b> Slot/gauze <b>.020</b> Length <b>30</b> Set between <b>12</b> ft. and <b>42</b> ft. ft. and <b>42</b> ft. Gravel pack? <b>yes</b> Size range of material <b>.030/.060</b>	
<b>Yell Coarse Gravel</b>			<b>35</b>	<b>38</b>	11. Static water level: <b>12</b> ft. below land surface Date <b>6-19-79</b> mo./day/yr.	
<b>Black Shale &amp; Limestone</b>			<b>38</b>	<b>80</b>	12. Pumping level below land surfaces: <b>Alvin Test</b> ft. after <b>0</b> hrs. pumping <b>12</b> g.p.m. ft. after <b>0</b> hrs. pumping <b>12</b> g.p.m. Estimated maximum yield <b>12</b> g.p.m.	
					13. Water sample submitted: <b>Yes</b> <input checked="" type="checkbox"/> No <input type="checkbox"/> Date <b>6-19-79</b> mo./day/yr.	
					14. Well head completion: <b>Top Cap</b> Pitless adapter <b>24</b> inches above grade	
					15. Well grouted? <b>yes</b> With: <input checked="" type="checkbox"/> Neat cement <input type="checkbox"/> Bentonite <input type="checkbox"/> Concrete Depth: From <b>0</b> ft. to <b>10</b> ft.	
					16. Nearest source of possible contamination: <b>Drain ditch</b> ft. <b>100</b> Direction <b>E</b> Type <b>Ditch</b> Well disinfected upon completion? <input type="checkbox"/> Yes <input type="checkbox"/> No	
					17. Pump: <input checked="" type="checkbox"/> Not installed Manufacturer's name _____ Model number _____ HP _____ Volts _____ Length of drop pipe _____ ft. capacity _____ g.p.m. Type: <input type="checkbox"/> Submersible <input type="checkbox"/> Turbine <input type="checkbox"/> Jet <input type="checkbox"/> Reciprocating <input type="checkbox"/> Centrifugal <input type="checkbox"/> Other	
(Use a second sheet if needed)						
18. Elevation: <b>1071</b> Topography: <b>Slope</b> <input checked="" type="checkbox"/> Upland <input type="checkbox"/> Valley		19. Remarks: <b>owner to install slab.</b>		20. Water well contractor's certification: This well was drilled under my jurisdiction and this report is true to the best of my knowledge and belief. <b>STRADER DRILLING CO INC 182</b> Business name License No. Address <b>RT 1 Holton, KS</b> Signed <b>Dale Osborn</b> Date <b>6-19-79</b> Authorized representative		

BR = 1033  
D = 1059