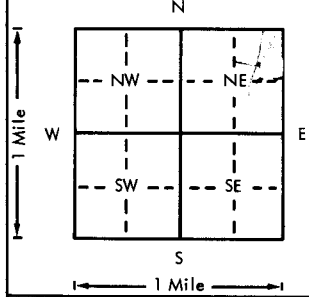
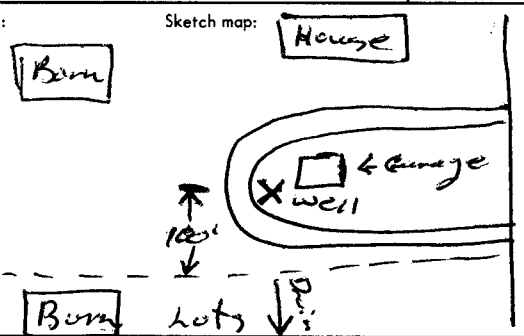


USE TYPEWRITER OR BALL
POINT PEN-PRESS FIRMLY,
PRINT CLEARLY.

WATER WELL RECORD
KSA 82a-1201-1215

Kansas Department of Health and
Environment-Division of Environment
(Water well Contractors)
Topeka, Kansas 66620

AAA

1. Location of well:		County Brown	Section number 2	Township number 3	Range number 18
2. Distance and direction from nearest town or city: 9 E 2 1/4 S		3. Owner of well: A. W. Oltjen R.R. or street: R. R. City, state, zip code: Robinson, KS			
4. Locate with "X" in section below:		Sketch map:			
					
5. Type and color of material		From To			
Top Soil		0 2			
Br Clay		2 20			
Brown Sandy Clay		20 31			
Rocks		31 32			
Brown Clay		32 34			
Brown Fine Sand		34 36			
Brown Med. Sand		36 50			
Coarse Gravel		50 53			
Brown Clay		53 54			
Gray Clay		54 57			
Coarse to Med Gravel		57 60			
Gray Clay		60 63			
Coarse Gravel		63 65			
Gray Clay		65 69			
Gray Limestone		69 70			
18. Elevation: 1080'		19. Remarks: Owner will construct cement slab around well			
Topography: <input type="checkbox"/> Hill <input checked="" type="checkbox"/> Slope <input type="checkbox"/> Upland <input type="checkbox"/> Valley		20. Water well contractor's certification: This well was drilled under my jurisdiction and this report is true to the best of my knowledge and belief. STRADER DAUG CO. INC. 182 Business name License No. Address RT 1 HOLLAND, KS Signed Dale Gibson Date 6-14-77 Authorized representative			

BR = 1011 ∇ = 1040