


1 LOCATION OF WATER WELL: Fraction NW 1/4 NW 1/4 NW 1/4 Section Number 36 Township Number T 33 S 3 Range Number R 18 E W  
 County: Brown

Distance and direction from nearest town or city street address of well if located within city?  
4 1/2 miles South West of Leona

2 WATER WELL OWNER: John L Andrews  
 RR#, St. Address, Box #: Everest, KS Box 65  
 City, State, ZIP Code: 66424  
 Board of Agriculture, Division of Water Resources  
 Application Number: X 1025

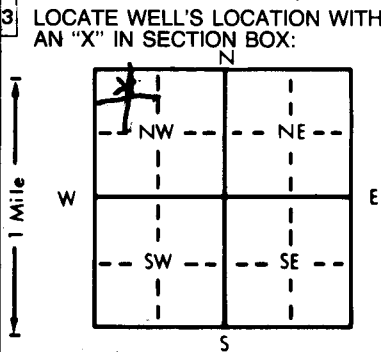

4 DEPTH OF COMPLETED WELL: 32 ft. ELEVATION: X 1025  
 Depth(s) Groundwater Encountered 1. 2.6 ft. 2. .... ft. 3. .... ft.  
 WELL'S STATIC WATER LEVEL 17 ft. below land surface measured on mo/day/yr 2-27-90  
 Pump test data: Well water was 22 ft. after 3 hours pumping 5 gpm  
 Est. Yield 5 gpm: Well water was 22 ft. after 34 hours pumping 5 gpm  
 Bore Hole Diameter: 5.4 in. to 20 ft., and 4.2 in. to 32 ft.  
 WELL WATER TO BE USED AS: 5 Public water supply 8 Air conditioning 11 Injection well  
 1 Domestic 3 Feedlot 6 Oil field water supply 9 Dewatering 12 Other (Specify below)  
 2 Irrigation 4 Industrial 7 Lawn and garden only 10 Observation well  
 Was a chemical/bacteriological sample submitted to Department? Yes No If yes, mo/day/yr sample was sub-  
 mitted Water Well Disinfected?  Yes  No

5 TYPE OF BLANK CASING USED: 5 Wrought iron  8 Concrete tile CASING JOINTS:  Glued  Clamped  
 1 Steel 3 RMP (SR) 6 Asbestos-Cement 9 Other (Specify below) Welded  
 2 PVC 4 ABS 7 Fiberglass Threaded  
 Blank casing diameter 36 in. to 32 ft., Dia. .... in. to .... ft., Dia. .... in. to .... ft.  
 Casing height above land surface 30 in., weight 320 lbs./ft. Wall thickness or ga. 3"  
 TYPE OF SCREEN OR PERFORATION MATERIAL: 7 PVC 10 Asbestos-cement  
 1 Steel 3 Stainless steel 5 Fiberglass 8 RMP (SR) 11 Other (specify)  
 2 Brass 4 Galvanized steel 6 Concrete tile 9 ABS  12 None used (open hole)  
 SCREEN OR PERFORATION OPENINGS ARE: 5 Gauzed wrapped 8 Saw cut 11 None (open hole)  
 1 Continuous slot 3 Mill slot 6 Wire wrapped 9 Drilled holes  
 2 Louvered shutter 4 Key punched 7 Torch cut 10 Other (specify)  
 SCREEN-PERFORATED INTERVALS: From .... ft. to .... ft., From .... ft. to .... ft.  
 GRAVEL PACK INTERVALS: From .... ft. to .... ft., From .... ft. to .... ft.

6 GROUT MATERIAL:  Neat cement 2 Cement grout 3 Bentonite 4 Other  
 Grout Intervals: From 0 ft. to 20 ft., From .... ft. to .... ft., From .... ft. to .... ft.  
 What is the nearest source of possible contamination:  10 Livestock pens 14 Abandoned water well  
 1 Septic tank 4 Lateral lines 7 Pit privy 11 Fuel storage 15 Oil well/Gas well  
 2 Sewer lines 5 Cess pool 8 Sewage lagoon 12 Fertilizer storage 16 Other (specify below)  
 3 Watertight sewer lines 6 Seepage pit 9 Feedyard 13 Insecticide storage  
 Direction from well? WEST How many feet? 350'

FROM	TO	LITHOLOGIC LOG	FROM	TO	LITHOLOGIC LOG
0	35	BLACK TOP SOIL			
35	8	GRAY CLAY			
8	17	YELLOW CLAY			
17	26	SAME WITH TRACES OF DRY YELLOW SAND			
26	32	LARGE BROWN/YELLOW GRAVEL - EGG SIZE VERY PRODUCTIVE			
32		BOTTOM HARD-BLUE SHALE			

7 CONTRACTOR'S OR LANDOWNER'S CERTIFICATION: This water well was  constructed (2) reconstructed, or (3) plugged under my jurisdiction and was completed on (mo/day/year) 2-27-90 and this record is true to the best of my knowledge and belief. Kansas Water Well Contractor's License No. 320 This Water Well Record was completed on (mo/day/yr) 3-24-90 under the business name of POPPLEWELL WELL BORING by (signature) Derry Popplewell  
 INSTRUCTIONS: Use typewriter or ball point pen, PLEASE PRESS FIRMLY and PRINT clearly. Please fill in blanks, underline or circle the correct answers. Send top three copies to Kansas Department of Health and Environment, Division of Environment, Environmental Geology Section, Topeka, KS 66620. Send one to WATER WELL OWNER and retain one for your records.