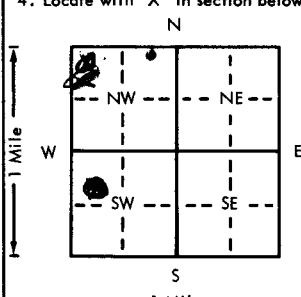


USE TYPEWRITER OR BALL
POINT PEN-PRESS FIRMLY,
PRINT CLEARLY.

WATER WELL RECORD
KSA 82a-120J-1215J

Kansas Department of Health and
Environment-Division of Environment
(Water well Contractors)
Topeka, Kansas 66620

1. Location of well:		County Doniphan	Fraction NE 1/4	Section number 1	Township number T 3	Range number S R 19	E/W
2. Distance and direction from nearest town or city: 2 E 25.5 W		3. Owner of well: Jim Twombly		R.R. or street: RA 1			
Street address of well location if in city: OF Highland		City, state, zip code: Highland, KS					
4. Locate with "X" in section below:		Sketch map:		6. Bore hole dia. 10 in. Completion date 10-25-76			
				Well depth 118 ft.			
5. Type and color of material		From		To		7. Cable tool <input checked="" type="checkbox"/> Rotary <input type="checkbox"/> Driven <input type="checkbox"/> Dug	
Top soil		0		5		<input type="checkbox"/> Hollow rod <input type="checkbox"/> Jetted <input type="checkbox"/> Bored <input type="checkbox"/> Reverse rotary	
Clay - Brown		5		45		8. Use: <input checked="" type="checkbox"/> Domestic <input type="checkbox"/> Public supply <input type="checkbox"/> Industry	
Coarse sand		45		50		<input type="checkbox"/> Irrigation <input type="checkbox"/> Air conditioning <input type="checkbox"/> Stock	
Limestone - (shaley)		50		118		<input type="checkbox"/> Lawn <input type="checkbox"/> Oil field water <input type="checkbox"/> Other	
						9. Casing: Material PVC Height Above or below	
						Threaded <input type="checkbox"/> Welded <input type="checkbox"/> Surface 24 in.	
						RMP <input type="checkbox"/> PVC 46 Weight 2.58 lbs./ft.	
						Dia. 5 in. to 118 ft. depth Wall Thickness: inches or	
						Dia. <input type="checkbox"/> in. to <input type="checkbox"/> ft. depth gage No. 3.74	
						10. Screen: Manufacturer's name Pu-APCO	
						Type PVC Dia. 5	
						Slot/gauze 0.20 Length 20	
						Set between 40 ft. and 60 ft.	
						<input type="checkbox"/> ft. and <input type="checkbox"/> ft.	
						Gravel pack? <input checked="" type="checkbox"/> Size range of material 0.30 x 0.60	
						11. Static water level: 50 ft. below land surface Date 10-25-76	
						12. Pumping level below land surfaces: AIR TEST	
						<input type="checkbox"/> ft. after <input type="checkbox"/> hrs. pumping <input type="checkbox"/> g.p.m.	
						<input type="checkbox"/> ft. after <input type="checkbox"/> hrs. pumping <input type="checkbox"/> g.p.m.	
						Estimated maximum yield 4 g.p.m.	
						13. Water sample submitted: <input type="checkbox"/> Yes <input checked="" type="checkbox"/> No Date 10-25-76	
						14. Well head completion: CAP	
						<input type="checkbox"/> Pitless adapter 24 inches above grade	
						15. Well grouted? <input checked="" type="checkbox"/>	
						With: <input checked="" type="checkbox"/> Neat cement <input type="checkbox"/> Bentonite <input type="checkbox"/> Concrete	
						Depth: From 5 ft. to 15 ft.	
						16. Nearest source of possible contamination: SEPTIC	
						ft. 100 Direction E Type SEPTIC	
						Well disinfected upon completion? <input type="checkbox"/> Yes <input type="checkbox"/> No	
						17. Pump: <input checked="" type="checkbox"/> Not installed	
						Manufacturer's name STRADER DRUG CO INC	
						Model number RT1 HP 1/2 Volts 115	
						Length of drop pipe 182 ft. capacity 182 g.p.m.	
						Type: <input type="checkbox"/> Submersible <input type="checkbox"/> Turbine	
						<input type="checkbox"/> Jet <input type="checkbox"/> Reciprocating	
						<input type="checkbox"/> Centrifugal <input type="checkbox"/> Other	
18. Elevation: 1047		19. Remarks: OWNER WILL INSTALL SIAB		20. Water well contractor's certification:			
Topography: <input checked="" type="checkbox"/> Hill <input type="checkbox"/> Slope <input type="checkbox"/> Upland <input type="checkbox"/> Valley				This well was drilled under my jurisdiction and this report is true to the best of my knowledge and belief.			
				Business name STRADER DRUG CO INC License No. 182			
				Address RT1 HOLTOM, KS			
				Signed Steve Carter Date 10-26-76			
				Authorized representative			

BR = 997 V = 997