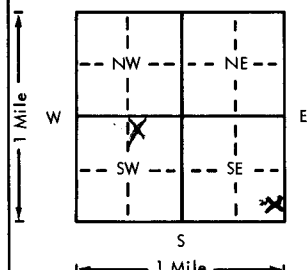


USE TYPEWRITER OR BALL
POINT PEN-PRESS FIRMLY,
PRINT CLEARLY.

WATER WELL RECORD
KSA 82a-1201-1215

Kansas Department of Health and
Environment-Division of Environment
(Water well Contractors)
Topeka, Kansas 66620

1. Location of well:		County <u>Donaghlin</u>	Fraction <u>SE 1/4 SE 1/4</u>	Section number <u>13</u>	Township number <u>3</u>	Range number <u>19</u>	<u>EW</u>
2. Distance and direction from nearest town or city: <u>1/2 N 1/2 E IN</u> Street address of well location if in city: <u>Severance, Ks.</u>				3. Owner of well: <u>John Dittmore Jr.</u> R.R. or street: <u>RR #1</u> City, state, zip code: <u>Severance, Ks. 66081</u>			
4. Locate with "X" in section below:		Sketch map:		6. Bore hole dia. <u>5</u> in. Completion date <u>5-2-77</u> Well depth <u>50</u> ft.			
		<u>well X ← 150' → Feed Lot</u>		7. <input checked="" type="checkbox"/> Cable tool <input checked="" type="checkbox"/> Rotary <input type="checkbox"/> Driven <input type="checkbox"/> Dug <input type="checkbox"/> Hollow rod <input type="checkbox"/> Jetted <input type="checkbox"/> Bored <input type="checkbox"/> Reverse rotary			
5. Type and color of material				From	To	8. Use: <input checked="" type="checkbox"/> Domestic <input type="checkbox"/> Public supply <input type="checkbox"/> Industry <input type="checkbox"/> Irrigation <input type="checkbox"/> Air conditioning <input checked="" type="checkbox"/> Stock <input type="checkbox"/> Lawn <input type="checkbox"/> Oil field water <input type="checkbox"/> Other	
<u>T.S.</u>				<u>0</u>	<u>10</u>	9. Casing: Material <u>PVC</u> Height: <u>Above</u> or below Threaded <input type="checkbox"/> Welded <input type="checkbox"/> Surface <u>24</u> in. RMP <input type="checkbox"/> PVC <u>Blue</u> Weight <u>2.74</u> lbs./ft. Dia. <u>5</u> in. to <u>50</u> ft. depth Wall Thickness: inches or Dia. <u>5</u> in. to <u>50</u> ft. depth gage No. <u>1258</u>	
<u>Br Clay</u>				<u>10</u>	<u>32</u>	10. Screen: Manufacturer's name <u>Purmo</u> Type <u>PVC</u> Dia. <u>5</u> Slot/gauze <u>.020</u> Length <u>10</u> Set between <u>40</u> ft. and <u>50</u> ft. Gravel pack? <u>yes</u> Size range of material <u>20-30</u>	
<u>Blue Clay</u>				<u>32</u>	<u>39</u>	11. Static water level: <u>35</u> ft. below land surface Date <u>5-2-77</u> mo./day/yr.	
<u>Brown Coarse Sand to Med Gravel</u>				<u>39</u>	<u>47</u>	12. Pumping level below land surfaces: <u>Air test</u> ft. after <u> </u> hrs. pumping <u> </u> g.p.m. ft. after <u> </u> hrs. pumping <u> </u> g.p.m. Estimated maximum yield <u>35</u> g.p.m.	
<u>Gray Shale</u>				<u>47</u>	<u>50</u>	13. Water sample submitted: <u> </u> mo./day/yr. Yes <input type="checkbox"/> No <input checked="" type="checkbox"/> Date <u> </u>	
						14. Well head completion: <u>Cap TOP</u> Pitless adapter <u>24</u> inches above grade	
						15. Well grouted? <u>yes</u> With: <input checked="" type="checkbox"/> Neat cement <input type="checkbox"/> Bentonite <input type="checkbox"/> Concrete Depth: From <u>0</u> ft. to <u>10</u> ft.	
						16. Nearest source of possible contamination: <u>Feed Lot</u> ft. <u>100</u> Direction <u>NE</u> Type <u>Lot</u> Well disinfected upon completion? <input checked="" type="checkbox"/> Yes <input type="checkbox"/> No	
						17. Pump: <input checked="" type="checkbox"/> Not installed Manufacturer's name <u> </u> Model number <u> </u> HP <u> </u> Volts <u> </u> Length of drop pipe <u> </u> ft. capacity <u> </u> g.p.m. Type: <input type="checkbox"/> Submersible <input type="checkbox"/> Turbine <input type="checkbox"/> Jet <input type="checkbox"/> Reciprocating <input type="checkbox"/> Centrifugal <input type="checkbox"/> Other	
(Use a second sheet if needed)							
18. Elevation: <u>912</u> Topography: <u> </u> <input type="checkbox"/> Hill <input type="checkbox"/> Slope <input type="checkbox"/> Upland <input checked="" type="checkbox"/> Valley		19. Remarks: <u>owner will install concrete slab around well</u>		20. Water well contractor's certification: This well was drilled under my jurisdiction and this report is true to the best of my knowledge and belief. <u>Stader Delq Co Inc. 182</u> Business name License No. Address <u>RT1 Holton Ks</u> Signed <u>Dale Parker</u> Date <u>5-3-77</u> Authorized representative			