

1 LOCATION OF WATER WELL:	Fraction	Section Number	Township Number	Range Number
County: Doniphan	SE ¼ SE ¼ SE ¼	6	T 3 S	R 19E E/W

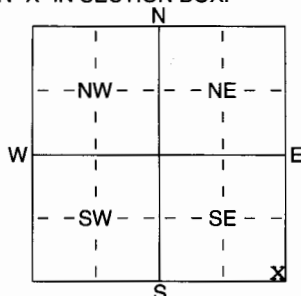
Distance and direction from nearest town or city street address of well if located within city?

2 1/4 miles North of Leona2 WATER WELL OWNER: **Bob McCauley**RR#, St. Address, Box # : **1383 Ashpoint Rd**City, State, ZIP Code : **Leona, Ks. 66532**

Board of Agriculture, Division of Water Resources

Application Number:

3 LOCATE WELL'S LOCATION WITH AN "X" IN SECTION BOX:

4 DEPTH OF COMPLETED WELL **100** ft. ELEVATION:Depth(s) Groundwater Encountered **1** ft. 2 ft. 3 ft.WELL'S STATIC WATER LEVEL **57** ft. below land surface measured on mo/day/yr **7-12-07**

Pump test data: Well water was ft. after hours pumping gpm

Est. Yield **40** gpm: Well water was ft. after hours pumping gpm

WELL WATER TO BE USED AS: 5 Public water supply 8 Air conditioning 11 Injection well

1 Domestic 3 Feedlot 6 Oil field water supply 9 Dewatering 12 Other (Specify below)

2 Irrigation 4 Industrial 7 Domestic (lawn & garden) 10 Monitoring well

Was a chemical/bacteriological sample submitted to Department? Yes No **X**; If yes, mo/day/yr sample was submittedWater Well Disinfected? Yes **X** No

5 TYPE OF BLANK CASING USED:

- 1 Steel 3 RMP (SR)
2 PVC 4 ABS

- 5 Wrought iron
6 Asbestos-Cement
7 Fiberglass

- 8 Concrete tile
9 Other (specify below)

CASING JOINTS: Glued **X** Clamped Welded ThreadedBlank casing diameter **5** in. to ft. Dia in. to ft. Dia in. to ft.Casing height above land surface **24** in. weight **2.82** lbs./ft. Wall thickness or gauge No. **258**

TYPE OF SCREEN OR PERFORATION MATERIAL:

- 1 Steel 3 Stainless Steel
2 Brass 4 Galvanized Steel

- 5 Fiberglass
6 Concrete tile

- 7 PVC
8 RMP (SR)
9 ABS

- 10 Asbestos-Cement
11 Other (Specify)
12 None used (open hole)

SCREEN OR PERFORATION OPENINGS ARE:

- 1 Continuous slot 3 Mill slot
2 Louvered shutter 4 Key punched

- 5 Guazed wrapped
6 Wire wrapped
7 Torch cut

- 8 Saw cut 11 None (open hole)
9 Drilled holes
10 Other (specify) ft.

SCREEN-PERFORATED INTERVALS: From **83** ft. to **93** ft. From ft. to ft.

From ft. to ft. From ft. to ft.

GRAVEL PACK INTERVALS: From **25** ft. to **100** ft. From ft. to ft.

From ft. to ft. From ft. to ft.

6 GROUT MATERIAL:

1 Neat cement

2 Cement grout

3 Bentonite

4 Other

Grout Intervals: From **0** ft. to **25** ft. From ft. to ft. From ft. to ft.

What is the nearest source of possible contamination:

- 1 Septic tank 4 Lateral lines
2 Sewer lines 5 Cess pool
3 Watertight sewer lines 6 Seepage pit

- 7 Pit privy
8 Sewage lagoon
9 Feedyard

- 10 Livestock pens 14 Abandoned water well
11 Fuel storage 15 Oil well/Gas well
12 Fertilizer storage 16 Other (specify below)
13 Insecticide storage **open field**

Direction from well?

How many feet?

FROM	TO	LITHOLOGIC LOG	FROM	TO	PLUGGING INTERVALS
0	1	sandy top soil			
1	17	clay brown silty			
17	21	clay ted brown			
21	33	silty clay tan			
33	58	clay tan			
58	72	fine/course sand brown			
72	85	fien/course sand brown pea, small, med			
85	87	course sand brown small pea med pea			
87	93	fine/course sand brown			
93	100	blue clay			

7 CONTRACTOR'S OR LANDOWNER'S CERTIFICATION: This water well was (1) constructed, (2) reconstructed, or (3) plugged under my jurisdiction and was completed on (mo/day/year) **7-12-07** and this record is true to the best of my knowledge and belief. KansasWater Well Contractor's Licence No **182** This Water Well Record was completed on (mo/day/yr) **9-27-07**under the business name of **Strader Drilling Co., Inc.** by (signature) **[Signature]**