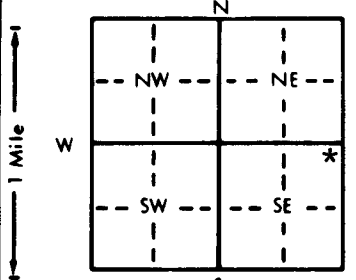


1 LOCATION OF WATER WELL: County: **Washington** Fraction: **NE 1/4 NE 1/4 SE 1/4** Section Number: **16** Township Number: **T 3 S** Range Number: **R 2 E/W**

Distance and direction from nearest town or city street address of well if located within city?  
**2 South, 1 3/4 West & 1 1/2 South of Morrowville**

2 WATER WELL OWNER: ~~XXXX~~ **Stan Brustowicz**  
 RR#, St. Address, Box #: **1537 Indian Road** Board of Agriculture, Division of Water Resources  
 City, State, ZIP Code: **Morrowville, KS. 66958** Application Number:

3 LOCATE WELL'S LOCATION WITH AN "X" IN SECTION BOX:  

 4 DEPTH OF COMPLETED WELL: **1.20** ft. ELEVATION:  
 Depth(s) Groundwater Encountered 1. .... ft. 2. .... ft. 3. .... ft.  
 WELL'S STATIC WATER LEVEL **65** ft. below land surface measured on mo/day/yr **8/14/00**  
 Pump test data: Well water was .... ft. after .... hours pumping .... gpm  
 Est. Yield **30** gpm: Well water was .... ft. after .... hours pumping .... gpm  
 Bore Hole Diameter: **10"** in. to **122** ft., and .... in. to .... ft.  
 WELL WATER TO BE USED AS:  
 1 Domestic 3 Feedlot 6 Oil field water supply 9 Dewatering 12 Other (Specify below)  
 2 Irrigation 4 Industrial 7 Lawn and garden only 10 Monitoring well  
 Was a chemical/bacteriological sample submitted to Department? Yes.....No.....\*  
 If yes, mo/day/yr sample was submitted  
 Water Well Disinfected? Yes \* No

5 TYPE OF BLANK CASING USED:  
 1 Steel 3 RMP (SR) 5 Wrought iron 8 Concrete tile CASING JOINTS: Glued \* Clamped  
 2 PVC 4 ABS 6 Asbestos-Cement 9 Other (specify below) Welded  
 7 Fiberglass Threaded  
 Blank casing diameter **5** in. to **100** ft., Dia. .... in. to .... ft., Dia. .... in. to .... ft.  
 Casing height above land surface **18** in., weight **190** lbs./ft. Wall thickness or gauge No. ....  
 TYPE OF SCREEN OR PERFORATION MATERIAL:  
 1 Steel 3 Stainless steel 5 Fiberglass 8 RMP (SR) 10 Asbestos-cement  
 2 Brass 4 Galvanized steel 6 Concrete tile 9 ABS 12 None used (open hole)  
 SCREEN OR PERFORATION OPENINGS ARE:  
 1 Continuous slot 3 Mill slot 5 Gauzed wrapped 8 Saw cut 11 None (open hole)  
 2 Louvered shutter 4 Key punched 7 Torch cut 10 Other (specify) ....  
 SCREEN-PERFORATED INTERVALS: From **100** ft. to **120** ft., From .... ft. to .... ft.  
 From .... ft. to .... ft., From .... ft. to .... ft.  
 GRAVEL PACK INTERVALS: From **40** ft. to **120** ft., From .... ft. to .... ft.  
 From .... ft. to .... ft., From .... ft. to .... ft.

6 GROUT MATERIAL: 1 Neat cement 2 Cement grout 3 Bentonite 4 Other  
 Grout Intervals: From **5** ft. to **40** ft., From .... ft. to .... ft., From .... ft. to .... ft.  
 What is the nearest source of possible contamination:  
 1 Septic tank 4 Lateral lines 7 Pit privy 10 Livestock pens 14 Abandoned water well  
 2 Sewer lines 5 Cess pool 8 Sewage lagoon 11 Fuel storage 15 Oil well/Gas well  
 3 Watertight sewer lines 6 Seepage pit 9 Feedyard 12 Fertilizer storage 16 Other (specify below)  
 13 Insecticide storage  
 Direction from well? **SE** How many feet? **250**

FROM	TO	LITHOLOGIC LOG	FROM	TO	PLUGGING INTERVALS
0	3	Topsoil			
3	16	Tan Clay			
16	40	Yellow & Tan Clay			
40	51	Sandstone & Tan Clay			
51	96	Sandstone (White)			
96	112	Sandstone (Yellow)			
112	122	Red & White Clay			

7 CONTRACTOR'S OR LANDOWNER'S CERTIFICATION: This water well was (1) constructed, (2) reconstructed, or (3) plugged under my jurisdiction and was completed on (mo/day/year) **8/14/00** and this record is true to the best of my knowledge and belief. Kansas Water Well Contractor's License No. **518** This Water Well Record was completed on (mo/day/yr) **8/20/00** under the business name of **Blue Valley Drilling** by (signature) *[Signature]*

OFFICE USE ONLY  
T  
R  
EW  
SEC.