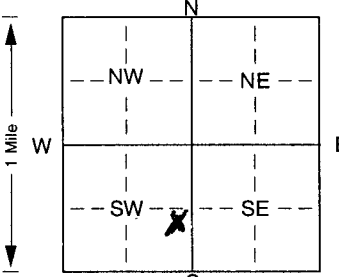


uw330

1 LOCATION OF WATER WELL: Fraction NE 1/4 S12 1/4 SW 1/4 Section Number 16 Township Number T 3 S Range Number R 2 E
 County: WASHINGTON

Distance and direction from nearest town or city street address of well if located within city?
FROM WASHINGTON: 8 MILES WEST ON HWY 36, 2 MILES SOUTH, 3/4 MILES WEST ON 15th RD.

2 WATER WELL OWNER: LEE & DORE NANNINGA
 RR#, St. Address, Box #: 913 15TH RD Board of Agriculture, Division of Water Resources
 City, State, ZIP Code: MORROWVILLE, KS 66758 Application Number: _____

3 LOCATE WELL'S LOCATION WITH AN "X" IN SECTION BOX:

 4 DEPTH OF COMPLETED WELL: 240 ft. ELEVATION: _____
 Depth(s) Groundwater Encountered 1. 240 ft. 2. _____ ft. 3. _____ ft.
 WELL'S STATIC WATER LEVEL: 106 ft. below land surface measured on mo/day/yr 5/28/02
 Pump test data: Well water was _____ ft. after _____ hours pumping _____ gpm
 Est. Yield 35 gpm: Well water was _____ ft. after _____ hours pumping _____ gpm
 Bore Hole Diameter: 8.75 in. to _____ ft., and _____ in. to _____ ft.
 WELL WATER TO BE USED AS:
 Domestic 3 Feedlot 6 Oil field water supply 9 Dewatering 12 Other (Specify below)
 2 Irrigation 4 Industrial 7 Domestic (lawn & garden) 10 Monitoring well
 Was a chemical/bacteriological sample submitted to Department? Yes. _____ No ; If yes, mo/day/yr sample was submitted
 Water Well Disinfected? Yes No _____

5 TYPE OF BLANK CASING USED:
 1 Steel 2 PVC 3 RMP (SR) 4 ABS 5 Wrought iron 6 Asbestos-Cement 7 Fiberglass 8 Concrete tile 9 Other (specify below) 10 Asbestos-cement
 Blank casing diameter 5 in. to 220 ft., Dia _____ in. to _____ ft., Dia _____ in. to _____ ft.
 Casing height above land surface 24 in., weight _____ lbs./ft. Wall thickness or gauge No. SDR26
 TYPE OF SCREEN OR PERFORATION MATERIAL:
 1 Steel 2 Brass 3 Stainless steel 4 Galvanized steel 5 Fiberglass 6 Concrete tile 7 RMP (SR) 8 ABS 9 Other (specify) 10 Asbestos-cement 11 Other (specify) 12 None used (open hole)
 SCREEN OR PERFORATION OPENINGS ARE:
 1 Continuous slot 2 Louvered shutter 3 Mill slot 4 Key punched 5 Gauzed wrapped 6 Wire wrapped 7 Torch cut 8 Saw cut 9 Drilled holes 10 Other (specify) 11 None (open hole)
 SCREEN-PERFORATED INTERVALS: From 220 ft. to 240 ft., From _____ ft. to _____ ft., From _____ ft. to _____ ft.
 GRAVEL PACK INTERVALS: From 25 ft. to 240 ft., From _____ ft. to _____ ft., From _____ ft. to _____ ft.

6 GROUT MATERIAL: 1 Neat cement 2 Cement grout 3 Bentonite 4 Other _____
 Grout Intervals: From 0 ft. to 25 ft., From _____ ft. to _____ ft., From _____ ft. to _____ ft.
 What is the nearest source of possible contamination:
 1 Septic tank 2 Sewer lines 3 Watertight sewer lines 4 Lateral lines 5 Cess pool 6 Seepage pit 7 Pit privy 8 Sewage lagoon 9 Feedyard 10 Livestock pens 11 Fuel storage 12 Fertilizer storage 13 Insecticide storage 14 Abandoned water well 15 Oil well/Gas well 16 Other (specify below)
 Direction from well? EAST How many feet? ~100'

FROM	TO	LITHOLOGIC LOG	FROM	TO	PLUGGING INTERVALS
0	15	CLAY			
15	22	SANDSTONE			
22	69	CLAY LIGHT GRAY			
69	80	SANDSTONE LIGHT GRAY			
80	169	CLAY, RED			
169	240	SANDSTONE, TAN			
	240	TOTAL DEPTH			

7 CONTRACTOR'S OR LANDOWNER'S CERTIFICATION: This water well was (1) constructed, (2) reconstructed, or (3) plugged under my jurisdiction and was completed on (mo/day/year) 5/28/02 and this record is true to the best of my knowledge and belief. Kansas Water Well Contractor's Licence No. 505 This Water Well Record was completed on (mo/day/yr) 6/27/02 under the business name of ASSOCIATED ENVIRONMENTAL, INC. by (signature) [Signature]