


WATER WELL PLUGGING RECORD Form WWC-5P KSA 82a-1212 ID NO.

1 LOCATION OF WATER WELL: County: Washington	Fraction Near Center SW 1/4	Section Number 36	Township Number T3S	Range Number R2 EW
---	---------------------------------------	-----------------------------	-------------------------------	--

Distance and direction from nearest town or city street address of well if located within city?

4 miles North and 3 miles West of Linn, KS.

2 WATER WELL OWNER: Calvin Wilgers RR#, St. Address, Box #: PO Box 246 City, State ZIP Code: Linn, KS 66953	Global Positioning Systems (decimal degrees, min. of 4 digits) Latitude: 39° 44' 39.7" Longitude: 097° 9' 25" Elevation: _____ Datum: _____ Data Collection Method: Hand Held
--	---

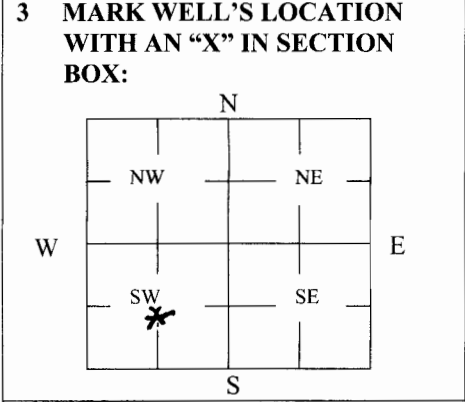

4 DEPTH OF WELL 227 **ft.**

WELL'S STATIC WATER LEVEL 139 **ft**

WELL WAS USED AS:

1 Domestic	5 Public Water Supply	9 Dewatering
2 Irrigation	6 Oil Field Water Supply	10 Monitoring
3 Feeder	7 Domestic (Lawn & Garden)	11 Injection Well
4 Industrial	8 Air Conditioning	12 Other _____

Was a chemical/bacteriological sample submitted to Department? Yes _____ No **X**

5 TYPE OF BLANK CASING USED:

1 Steel	3 RMP (SR)	5 Wrought	7 Fiberglass	9 Other (Specify below)
2 PVC	4 ABS	6 Asbestos-Cement	8 Concrete Tile	_____

Blank casing diameter 12 in. Was casing pulled? Yes _____ No **X** If yes, how much _____
Casing height above or below land surface 12 in.

6 GROUT PLUG MATERIAL: 1 Neat cement 2 Cement grout **3 Bentonite** 4 Other _____

Grout Plug Intervals: From 3 ft. to 6 ft., From 129 ft. to 149 ft., From _____ to _____ ft.

What is the nearest source of possible contamination:

1 Septic tank	6 Seepage pit	11 Fuel Storage	16 Other (specify below)
2 Sewer lines	7 Pit privy	12 Fertilizer storage	_____
3 Watertight sewer lines	8 Sewage lagoon	13 Insecticide storage	_____
4 Lateral lines	9 Feedyard	14 Abandoned water well	Direction from well Southwest
5 Cess pool	10 Livestock pens	15 Oil well/Gas well	How many feet? 1000'

FROM	TO	PLUGGING MATERIALS	FROM	TO	PLUGGING MATERIALS
0'	3'	Native soil			
3'	6'	Bentonite cap			
6'	129'	Chlorinated gravel			
129'	149'	Bentonite			
149'	227'	Chlorinated gravel			

7 CONTRACTOR'S OR LANDOWNER'S CERTIFICATION: This water well was plugged under my jurisdiction and was completed on (mo/day/year) 2-24-09 and this record is true to the best of my knowledge and belief. Kansas Water Well Contractor's License No. 755. This Water Well Record was completed on (mo/day/year) 3-27-09 under the business name of **Sargent Drilling** by (signature)

INSTRUCTIONS: Use typewriter or ballpoint pen. Please press firmly and print clearly. Please fill in blanks, underline or circle the correct answers. Send top three copies to Kansas Department of Health and Environment, Bureau of Water, Geology Section, 1000 SW Jackson St., Ste. 420, Topeka, Kansas 66612-1367. Telephone: 785/296-5522. Send one to Water Well Owner and retain one for your records. Visit us at <http://www.kdheks.gov/geo/waterwells>.