


| | | | | | |
|---|---------------------------|----------------------|----------------|-----------------|--------------|
| 1 | LOCATION OF WATER WELL: | Fraction | Section Number | Township Number | Range Number |
| | County: <u>Washington</u> | <u>SW 1/4 SW 1/4</u> | <u>24</u> | <u>3</u> | <u>2</u> E/W |

Distance and direction from nearest town or city street address of well if located within city?
2 miles south, 1/2 mile east, 3 miles south of Morrowville

| | | |
|---|---|---|
| 2 | WATER WELL OWNER: <u>Scott Weber</u> | Board of Agriculture, Division of Water Resources |
| | RR #, St. Address, Box #: <u>1211 14th Rd</u> | Application Number: |
| | City, State, ZIP Code: <u>Washington KS 66908</u> | |

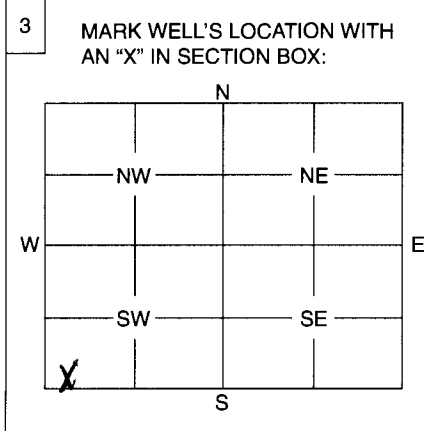

4 DEPTH OF WELL 72 ft.

WELL'S STATIC WATER LEVEL 10 ft.

WELL WAS USED AS:

| | | |
|--------------|----------------------------|--------------------|
| 1 Domestic | 5 Public Water Supply | 9 Dewatering |
| 2 Irrigation | 6 Oil Field Water Supply | 10 Monitoring Well |
| 3 Feedlot | 7 Domestic (Lawn & Garden) | 11 Injection Well |
| 4 Industrial | 8 Air Conditioning | 12 Other |

Was a chemical / bacteriological sample submitted to Department? Yes No

If yes, mo/day/yr sample was submitted

Water Well Disinfected: Yes No

5 TYPE OF BLANK CASING USED:

Steel 3 RMP (SR) 5 Wrought 7 Fiberglass 9 Other (Specify below)

2 PVC 4 ABS 6 Asbestos-Cement 8 Concrete Tile

Blank casing diameter 10 in. Was casing pulled? Yes No If yes, how much

Casing height above or below land surface in.

6 GROUT PLUG MATERIAL: 1 Neat cement 2 Cement grout Bentonite 4 Other

Grout Plug Intervals: From ft. to ft., From ft. to ft., From to ft.

What is the nearest source of possible contamination:

| | | | |
|--------------------------|-------------------|-------------------------|--------------------------|
| 1 Septic tank | 6 Seepage pit | 11 Fuel storage | 16 Other (specify below) |
| 2 Sewer lines | 7 Pit privy | 12 Fertilizer storage | |
| 3 Watertight sewer lines | 8 Sewage lagoon | 13 Insecticide storage | |
| 4 Lateral lines | 9 Feedyard | 14 Abandoned water well | |
| 5 Cess pool | 10 Livestock pens | 15 Oil well/Gas well | |

Direction from well? How many feet?

| FROM | TO | PLUGGING MATERIALS |
|--------------|--------------|-------------------------|
| <u>0 ft</u> | <u>3 ft</u> | <u>Topsoil</u> |
| <u>3 ft</u> | <u>10 ft</u> | <u>Bentonite Plug</u> |
| <u>10 ft</u> | <u>62 ft</u> | <u>Subsoil fill</u> |
| <u>62 ft</u> | <u>72 ft</u> | <u>Chlorinated Sand</u> |
| | | |
| | | |

7 CONTRACTOR'S OF LANDOWNER'S CERTIFICATION: This water well was plugged under my jurisdiction and was completed on (mo/day/year) and this record is true to the best of my knowledge and belief. Kansas Water Well Contractor's License No. This Water Well Record was completed on (mo/day/year) under the business name of by (signature) [Signature]

INSTRUCTIONS: Use typewriter or ball point pen. Please press firmly and print clearly. Please fill in blanks, underline or circle the correct answers. Send top three copies to Kansas Department of Health and Environment, Bureau of Water, Geology Section, 1000 SW Jackson St., Ste. 420, Topeka, Kansas 66612-1367. Telephone: 785/296-5522. Send one to Water Well Owner and retain one for your records.