

USE TYPEWRITER OR BALL
POINT PEN-PRESS FIRMLY,
PRINT CLEARLY.

WATER WELL RECORD
KSA 82a-1201-1215


T	R	EW	sec	1/4 1/4 1/4 No.	

Kansas State Dept. Of Health
(Water Well Contractors)
Forbes-Bldg. 740
Topeka, Kansas 66620

1 Location of well:	County Washington	Township name Coleman	Fraction NE NE NW	Section number 33	Town number T3S	Range number R2E
---------------------	--------------------------	------------------------------	--------------------------	--------------------------	------------------------	-------------------------

Distance and direction from nearest town or city:
South of Morrowville to 15 & 36 junction
Street address of well location if in city:
1/2 east 4south 2 1/2 west

3 Owner of well:
Wayne Elliott
Address:
Washington, Kansas RFD 1

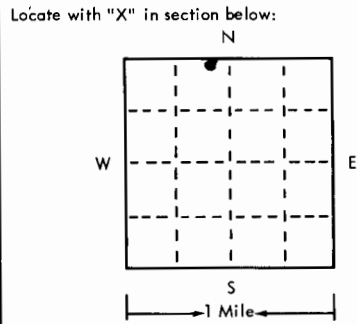

Sketch map:
NE 1/4 of NW 1/4 of NW 1/4
NE

4 Well depth: **144** ft. Date of completion **1/15/75**
Well diameter **8** in.

5 Cable tool Rotary Driven Dug
 Hollow rod Jetted Bored Reverse rotary

6 Use: Domestic Public supply Industry
 Irrigation Air conditioning Commercial
 Test well

7 Casing: Material **P.V.C.** Height: ~~above~~ **15** in.
Threaded Welded Surface **15** in.
Diam. **5** Weight **160** lbs. ~~160~~
— in. to **144** ft. depth Drive shoe? Yes No
— in. to — ft. depth

2 Type and color of material	From	To
Brown & Red clay	0	16
16 Blue sandy clay	16	22
Brown sand rock	22	48
Gray clay	48	76
Brown Sand rock	76	92
Red clay	103	112
Sand rock (p00r) not much water	112	128
Soft sand rock lot water	128	136
Blue clay	136	146
(use a second sheet if needed)		

8 Screen:
Manufacturer **Blue Valley Drilling**
Type **P.V.C.** Dia. **5 in.**
Slot/gauze **.060** Length **1/2 ft. 32**
Set between **88** and **120** ft. ~~140~~
Fittings: **C.M.X. 1/16**
Gravel pack Yes No Size range of material

9 Static water level:
80 ft. below land surface Date **1/15/75**

10 Pumping level below land surfaces:
— ft. after — hrs. pumping — g.p.m.
— ft. after — hrs. pumping — g.p.m.
Estimated maximum yield **50** g.p.m.

11 Water sample submitted:
 Yes No Date _____

12 Well head completion:
 Pitless adapter **13** inches above grade

13 Well grouted? Yes No
 Neat cement Bentonite
Depth: From **5** ft. to **15** ft.

14 Nearest source of possible contamination: **septic**
ft. **100** Direction **South** Type **Tank**
Well disinfected upon completion? Yes No

15 Pump: Not installed
Manufacturer's name _____
Model number _____ HP _____ Volts _____
Length of drop pipe _____ ft. capacity _____ g.m.p.
Type:
 Submersible Turbine
 Jet Reciprocating
 Centrifugal Other

16 Remarks: elevation **500'**
Topography:
 Hill
 Slope
 Upland
 Valley

17 Water well contractor's certification:
This well was drilled under my jurisdiction and this report is true to the best of my knowledge and belief.
Blue Valley Drilling **234**
Business name **Blue Rapids, Ks.** License No.
Address **Blue Rapids, Ks.**
Signed **Gerald Stant** Date **2/3/75**
Authorized representative