

USE TYPEWRITER OR BALL POINT PEN-PRESS FIRMLY, PRINT CLEARLY.


WATER WELL RECORD
KSA 82a-1201-1215

Kansas Department of Health and Environment-Division of Environment (Water well Contractors) Topeka, Kansas 66620

change legal

1. Location of well: County **DONIPHAN** Fraction **NE SW** ~~NW 1/4 SE~~ 1/4 NE 1/4 Section number **5** Township number **T 3 S R 20** Range number **20**

2. Distance and direction from nearest town or city: **4 miles east of Highland, Kansas and 3 miles south.** Street address of well location if in city: _____
3. Owner of well: **Blanton Farms, Inc.** R.R. or street: **RR 1, Troy, Kansas 66087** City, state, zip code: _____

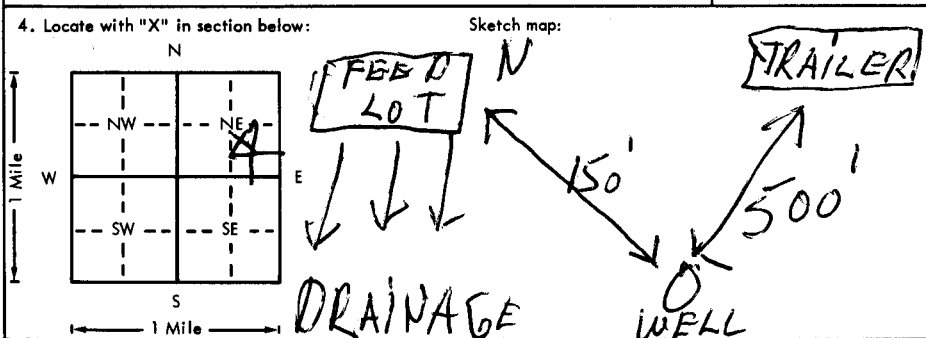

6. Bore hole dia. **34** in. Completion date **3/2/76** Well depth **42** ft. Bore Hole is **42** ft. to 10
7. Cable tool Rotary Driven Dug Hollow rod Jetted Bored Reverse rotary
8. Use: Domestic Public supply Industry Irrigation Air conditioning Stock Lawn Oil field water Other
9. Casing: Material **concrete** Height **Above** or below Threading Welded Surface **24** in. RMP PVC Weight **200** lbs./ft. Dia. **30** in. to **40** ft. depth Wall Thickness: inches or Dia. in. to ft. depth gage No. **2 in.**

5. Type and color of material	From	To
Black Topsoil	0	3 1/2
Brownish Silt	3 1/2	8
Silt, Brownish, very fine	8	14
Gray silt w/streaks of brown	14	21
Coarse to very coarse blue and gray water bearing sand - very productive	21	34
Blue Clay - Medium Hardness	34	42
<i>very hard no iron</i>		
(Use a second sheet if needed)		

10. Screen: Manufacturer's name _____ Type _____ Dia. _____ Slot/gauze **No No** Length _____ Set between _____ ft. and _____ ft. Gravel pack? Size range of material _____
11. Static water level: **12** ft. below land surface Date **3/3/76** mo./day/yr.
12. Pumping level below land surfaces: **24** ft. after **1** hrs. pumping **8** g.p.m. **36** ft. after **3** hrs. pumping **8** g.p.m. Estimated maximum yield **4 1/2** g.p.m.
13. Water sample submitted: Yes No Date _____ mo./day/yr.
14. Well head completion: Pitless adapter _____ inches above grade
15. Well grouted? X With: Neat cement Bentonite Concrete Depth: From **0** ft. to **10** ft.
16. Nearest source of possible contamination: ft. **150** Direction **NW** Type **Feed Lot** Well disinfected upon completion? X Yes No
17. Pump: X Not installed Manufacturer's name _____ Model number _____ HP _____ Volts _____ Length of drop pipe _____ ft. capacity _____ g.p.m. Type: Submersible Turbine Jet Reciprocating Centrifugal Other

18. Elevation: **910** Topography: Hill Slope Upland Valley
19. Remarks: **Concrete slab, and vent will be installed by customer. He knows and understands this is a regulation.** *Licensed Blanton*

20. Water well contractor's certification: This well was drilled under my jurisdiction and this report is true to the best of my knowledge and belief. **POPPELWELL WELL BORING 320** Business name _____ License No. _____ Address **Amity, MO** Signed *Poppe Well* Date **3/16/76** Authorized representative

Forward the white, blue and pink copies to the Department of Health and Environment

Form WWC-5

BR = 868 V = 898

T 3 S R 20 W 5 NE 1/4