USE TYPEWRITER OR BALL POINT PEN-PRESS FIRMLY, PRINT CLEARLY.

WATER WELL RECORD
KSA 82a-1201-1215

Kansas Department of Health and Environment-Division of Environment
(Water well Contractors)
Topeka, Kansas 66620

SE - SW - NW

1. Location of well:	County	Fraction	Section number	Township number	Range number
	Doniphan	~~NE NE NW~~ 1/4	~~34~~ 27	T 3 (S)	R 20 (E/W)

2. Distance and direction from nearest town or city: 1 N ½ E
Street address of well location if in city: Bendena

3. Owner of well: Kenneth Christapher
R.R. or street: RR.
City, state, zip code: Bendena, Ks.

4. Locate with "X" in section below:

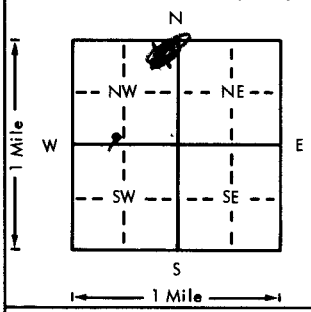

Sketch map:

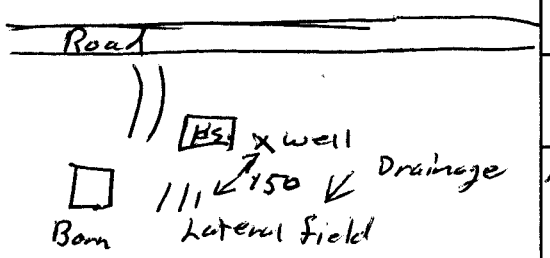

6. Bore hole dia. 10 in. Completion date
Well depth 90 ft. 12-7-76

7. __ Cable tool ✓ Rotary __ Driven __ Dug
__ Hollow rod __ Jetted __ Bored __ Reverse rotary

8. Use: ✓ Domestic __ Public supply __ Industry
__ Irrigation __ Air conditioning ✓ Stock
__ Lawn __ Oil field water __ Other

X. Casing: Material PVC Height: Above or below
Threaded ___ Welded ___ Surface 24 in.
RMP ___ PVC Glue Weight 2.55 lbs./ft.
Dia. X5 in. to X90 ft. depth Wall Thickness: inches or
Dia. ___ in. to ___ ft. depth gage No. 2.74

5. Type and color of material	From	To
T.S. Red Clay	0	15
Lt. Gray Silt	15	20
Red Clay	20	26
Tan Clay	26	48
Tan Clay (Sandy & Gravely	48	61
Gray Clay	61	68
Brown Med Sand	68	70
Gray Clay (Sandy)	70	77
Gray Limestone	77	90
(Use a second sheet if needed)		

10. Screen: Manufacturer's name Pumpco
Type PVC Dia. 5"
Slot/gauze .020 Length 10
Set between 68 ft. and 78 ft.
___ ft. and ___ ft.
Gravel pack? ✓ Size range of material .030X.060

11. Static water level: mo./day/yr.
50 ft. below land surface Date 12-7-76

12. Pumping level below land surfaces:
___ ft. after ___ hrs. pumping ___ g.p.m.
___ ft. after ___ hrs. pumping ___ g.p.m.
Estimated maximum yield 1½ g.p.m.

13. Water sample submitted: mo./day/yr.
___ Yes ✓ No Date

14. Well head completion: Capped
___ Pitless adapter 24 Inches above grade

15. Well grouted? ✓
With: ✓ Neat cement ___ Bentonite ___ Concrete
Depth: From 5 ft. to 15 ft.

16. Nearest source of possible contamination:
ft. 150 Direction SW Type Lateral
Well disinfected upon completion? ✓ Yes ___ No

17. Pump: ✓ Not installed
Manufacturer's name
Model number ___ HP ___ Volts ___
Length of drop pipe ___ ft. capacity ___ g.p.m.
Type:
___ Submersible ___ Turbine
___ Jet ___ Reciprocating
___ Centrifugal ___ Other

18. Elevation: ☑ 1089
Topography:
___ Hill
___ Slope
✓ Upland
___ Valley

19. Remarks:
Owner will pour cement slab around well

20. Water well contractor's certification:
This well was drilled under my jurisdiction and this report is true to the best of my knowledge and belief.
Strader Drlg Co Inc 182
Business name License No.
Address RT 1 Holton, Ks
Signed Dale Auburn Date 12-8-76
Authorized representative

T 3 S R 20 E/W Sec 34 1/4 1/4 1/4 1/4

Forward the white, blue and pink copies to the Department of Health and Environment

Form WWC-5

BR = 1012 ▽ = 1039