

Division of Environment  
Curtis State Office Building  
1000 SW Jackson St., Suite 410  
Topeka, KS 66612-1367



Phone: 785-296-1660  
Fax: 785-559-4261  
www.kdheks.gov

Lee A. Norman, M.D., Secretary

Laura Kelly, Governor

June 18, 2020

Lea Tipton  
KDHE-BER Orphan Sites Program  
1000 SW Jackson St, Suite 410  
Topeka, KS 66612

**RE: Monitoring Well Ownership Transfer  
Bendena RWD #2, PWS Well #1  
Bendena, KS 66008  
C4-022-00005**

Dear Ms. Tipton,

The United States Department of Agriculture (USDA) has requested ownership of monitoring wells MW-04P and MW-5, installed as part of the investigation of carbon tetrachloride contamination associated with the above referenced site. The USDA will be responsible for all future responsibilities of well ownership that includes, but is not limited to, maintenance, liability and eventual well plugging.

The attached signed monitoring well transfer form is for your records. Well ownership changed on June 5, 2020. If you have any questions please call me at 785-296-0268.

Sincerely,

Alex Richards  
Site Restoration Unit Chief  
Remedial Section  
Bureau of Environmental Remediation


Enclosure

cc Randy Carlson > Ken Diediker > file (C4-022-00005-1, C4-022-72078-1)  
Pam Chaffee, KDHE BOW  
District Administrator, KDHE NEDO  
Caroline Roe, USDA

1 LOCATION OF WATER WELL: County: Doniphan Fraction: NW 1/4 SW 1/4 SE 1/4 Section Number: 33 Township Number: T 03 S Range Number: R 20 E

Distance and direction from nearest town or city street address of well if located within city?  
Bendena, KS

2 WATER WELL OWNER: KDHE  
 RR#, St. Address, Box #: Forbes Field, Building 740 Board of Agriculture, Division of Water Resources  
 City, State, ZIP Code: Topeka, KS 66620 Application Number:

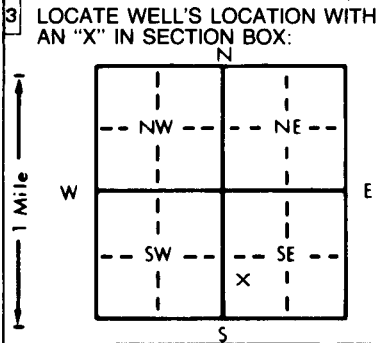

4 DEPTH OF COMPLETED WELL: 30 ft. ELEVATION:  
 Depth(s) Groundwater Encountered 1. .... ft. 2. .... ft. 3. .... ft.  
 WELL'S STATIC WATER LEVEL ..... ft. below land surface measured on mo/day/yr  
 Pump test data: Well water was ..... ft. after ..... hours pumping ..... gpm  
 Est. Yield ..... gpm: Well water was ..... ft. after ..... hours pumping ..... gpm  
 Bore Hole Diameter ..... in. to ..... ft., and ..... in. to ..... ft.  
 WELL WATER TO BE USED AS: 5 Public water supply 8 Air conditioning 11 Injection well  
 1 Domestic 3 Feedlot 6 Oil field water supply 9 Dewatering 12 Other (Specify below)  
 2 Irrigation 4 Industrial 7 Lawn and garden only 10 Monitoring well MW-04P  
 Was a chemical/bacteriological sample submitted to Department? Yes.....No.....; If yes, mo/day/yr sample was submitted  
 Water Well Disinfected? Yes No

5 TYPE OF BLANK CASING USED:  
 1 Steel 3 RMP (SR) 5 Wrought iron 8 Concrete tile CASING JOINTS: Glued ..... Clamped .....  
 2 PVC 4 ABS 6 Asbestos-Cement 9 Other (specify below) Welded .....  
 7 Fiberglass Threaded. x  
 Blank casing diameter ..... in. to ..... 20 ft., Dia ..... in. to ..... ft., Dia ..... in. to ..... ft.  
 Casing height above land surface ..... in., weight ..... lbs./ft. Wall thickness or gauge No. Sch. 40  
 TYPE OF SCREEN OR PERFORATION MATERIAL:  
 1 Steel 3 Stainless steel 5 Fiberglass 7 PVC 10 Asbestos-cement  
 2 Brass 4 Galvanized steel 6 Concrete tile 8 RMP (SR) 11 Other (specify) .....  
 9 ABS 12 None used (open hole)  
 SCREEN OR PERFORATION OPENINGS ARE:  
 1 Continuous slot 3 Mill slot 5 Gauzed wrapped 8 Saw cut 11 None (open hole)  
 2 Louvered shutter 4 Key punched 6 Wire wrapped 9 Drilled holes  
 7 Torch cut 10 Other (specify) .....  
 SCREEN-PERFORATED INTERVALS: From ..... 30 ft. to ..... 20 ft., From ..... ft. to ..... ft.  
 From ..... ft. to ..... ft., From ..... ft. to ..... ft.  
 GRAVEL PACK INTERVALS: From ..... 30 ft. to ..... 18 ft., From ..... ft. to ..... ft.  
 From ..... ft. to ..... ft., From ..... ft. to ..... ft.

6 GROUT MATERIAL: 1 Neat cement 2 Cement grout 3 Bentonite 4 Other .....  
 Grout Intervals: From ..... 18 ft. to ..... ft., From ..... ft. to ..... ft., From ..... ft. to ..... ft.  
 What is the nearest source of possible contamination:  
 1 Septic tank 4 Lateral lines 7 Pit privy 10 Livestock pens 14 Abandoned water well  
 2 Sewer lines 5 Cess pool 8 Sewage lagoon 11 Fuel storage 15 Oil well/Gas well  
 3 Watertight sewer lines 6 Seepage pit 9 Feedyard 12 Fertilizer storage 16 Other (specify below)  
 13 Insecticide storage  
 Direction from well? How many feet?

| FROM | TO | LITHOLOGIC LOG | FROM | TO | PLUGGING INTERVALS |
|------|----|----------------|------|----|--------------------|
|      |    | Not sampled    |      |    |                    |
|      |    |                |      |    |                    |
|      |    |                |      |    |                    |
7 CONTRACTOR'S OR LANDOWNER'S CERTIFICATION: This water well was (1) constructed, (2) reconstructed, or (3) plugged under my jurisdiction and was completed on (mo/day/year) 3/5/98 and this record is true to the best of my knowledge and belief. Kansas Water Well Contractor's License No. 549 This Water Well Record was completed on (mo/day/yr) 4/9/98 under the business name of J & R Drilling Services, Inc. by (signature) Don Carlson


**TRANSFER OF MONITORING WELL OWNERSHIP**


**Monitoring Well(s) Details**

Site Name: Bendena RWD #2, PWS Well #1  
Site Address: Bendena, KS 66008  
Monitoring Well Numbers: MW-04P, MW-05  
KDHE Site ID Number: C4-022-00005

**Current Well Owner(s) Information**

KDHE-Bureau of Environmental Remediation  
Orphan Sites Program  
1000 SW Jackson, Suite 410  
Topeka, Kansas 66612  
Contact: Lea Tipton  
Phone: (785) 291-3246  
Email: lea.tipton@ks.gov

  
\_\_\_\_\_  
Authorized Signature

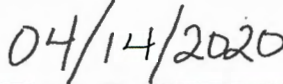  
\_\_\_\_\_  
Date

**New Well Owner(s) Information**

United States Department of Agriculture (USDA)  
1400 Independence Avenue SW  
STOP 0563, Room 4089-S  
Washington, DC 20250-0563  
Contact: Caroline Roe  
Phone: (202) 720-9964  
Email: caroline.roe@usda.gov

KDHE-BER-State Cooperative Program (SCP), Bendena USDA Site  
KDHE Site ID Number: C4-022-72078  
USDA Site ID Number: 404-KS

**CAROLINE ROE**  
\_\_\_\_\_  
Authorized Signature

Digitally signed by CAROLINE ROE  
Date: 2020.06.05 12:28:19 -04'00'

\_\_\_\_\_  
Date

Return Form to:

Lea Tipton  
KDHE-Bureau of Environmental Remediation  
Orphan Sites Program  
1000 SW Jackson, Suite 410  
Topeka, Kansas 66612