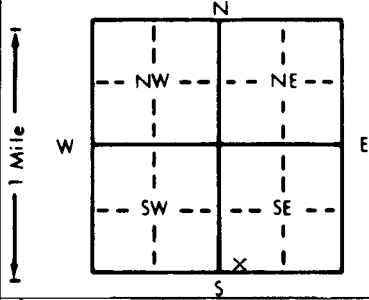


1 LOCATION OF WATER WELL:		Fraction		Section Number		Township Number		Range Number			
County: Doniphan		SW 1/4 SW 1/4 SE 1/4		33		T 13 S		R 20 E			
Distance and direction from nearest town or city street address of well if located within city? Bendena, KS											
2 WATER WELL OWNER: KOHE											
RR#, St. Address, Box #: Forbes Field, Building 740											
City, State, ZIP Code: Topeka, KS 66620											
Board of Agriculture, Division of Water Resources											
Application Number:											
3 LOCATE WELL'S LOCATION WITH AN "X" IN SECTION BOX:		4 DEPTH OF COMPLETED WELL: 140 ft. ELEVATION:									
		Depth(s) Groundwater Encountered 1. ft. 2. ft. 3. ft.									
		WELL'S STATIC WATER LEVEL ft. below land surface measured on mo/day/yr									
		Pump test data: Well water was ft. after hours pumping gpm									
		Est. Yield gpm: Well water was ft. after hours pumping gpm									
		Bore Hole Diameter in. to ft., and in. to ft.									
		WELL WATER TO BE USED AS: 5 Public water supply 8 Air conditioning 11 Injection well									
		1 Domestic 3 Feedlot 6 Oil field water supply 9 Dewatering 12 Other (Specify below)									
		2 Irrigation 4 Industrial 7 Lawn and garden only 10 Monitoring well MW-07									
		Was a chemical/bacteriological sample submitted to Department? Yes. No.; If yes, mo/day/yr sample was submitted									
		Water Well Disinfected? Yes No									
5 TYPE OF BLANK CASING USED:											
1 Steel 3 RMP (SR) 5 Wrought iron 8 Concrete tile CASING JOINTS: Glued Clamped											
2 PVC 4 ABS 6 Asbestos-Cement 9 Other (specify below) Welded											
7 Fiberglass Threaded. X											
Blank casing diameter 2 in. to 123 ft., Dia in. to ft., Dia in. to ft.											
Casing height above land surface 0 in., weight lbs./ft. Wall thickness or gauge No. Sch. 40											
TYPE OF SCREEN OR PERFORATION MATERIAL:											
1 Steel 3 Stainless steel 5 Fiberglass 7 PVC 10 Asbestos-cement											
2 Brass 4 Galvanized steel 6 Concrete tile 8 RMP (SR) 11 Other (specify)											
9 ABS 12 None used (open hole)											
SCREEN OR PERFORATION OPENINGS ARE:											
1 Continuous slot 3 Mill slot 5 Gauzed wrapped 8 Saw cut 11 None (open hole)											
2 Louvered shutter 4 Key punched 7 Torch cut 9 Drilled holes											
10 Other (specify)											
SCREEN-PERFORATED INTERVALS: From 138 ft. to 123 ft., From ft. to ft.											
From ft. to ft., From ft. to ft.											
GRAVEL PACK INTERVALS: From 140 ft. to 120 ft., From ft. to ft.											
From ft. to ft., From ft. to ft.											
6 GROUT MATERIAL: 1 Neat cement 2 Cement grout 3 Bentonite 4 Other											
Grout Intervals: From 120 ft. to 0 ft., From ft. to ft., From ft. to ft.											
What is the nearest source of possible contamination:											
1 Septic tank 4 Lateral lines 7 Pit privy 10 Livestock pens 14 Abandoned water well											
2 Sewer lines 5 Cess pool 8 Sewage lagoon 11 Fuel storage 15 Oil well/Gas well											
3 Watertight sewer lines 6 Seepage pit 9 Feedyard 12 Fertilizer storage 16 Other (specify below)											
13 Insecticide storage											
Direction from well? How many feet?											
FROM		TO		LITHOLOGIC LOG		FROM		TO		Cont. PERFORATION INTERVALS	
0		1		Asphalt, topsoil, clay w/silt		95		96		Sand brown fine grained wet	
1		5		Clay w/silt brown damp plastic		96		101		Silt gray-blk damp gravel some sand	
5		8		Silt w/some clay brown damp		101		103		Fine sand gray-blk wet clay gravel	
8		11		Clay w/silt damp soft plastic		103		107		Silt gray-black damp stiff gravel	
11		21		Clay w/silt gray red-brown streaks		107		109		Sand gray loose wet qtz feldspar	
21		35		Clay gray-brown damp stiff carbonaceous		109		123		Silt gray damp sand stiff	
35		54		Clay gray wet very stiff gravel		123		125		Gravel coarse sand loose wet shale	
54		56		Clay w/silt firm brown-gray moist-wet		125		126		Sand fine grained gray wet loose	
56		59		Silt w/clay brown moist caliche nodules							
59		63		Silt brown stiff moist gravel		126		127		Gravel coarse sand wet loose	
63		66		Caliche layer Clay w/silt brown damp		127		140		Silt gray stiff dry-damp possible shale	
66		70		Limestone gravel siltyw/clay brown							
70		80		Silt w/limestone gravel clay gray							
80		88		Sand brown wet loose fine grained							
88		95		XXXXXX SAND XXXX Silt gray-black stiff							
7 CONTRACTOR'S OR LANDOWNER'S CERTIFICATION: This water well was (1) constructed, (2) reconstructed, or (3) plugged under my jurisdiction and was completed on (mo/day/year) 2/20/98 and this record is true to the best of my knowledge and belief. Kansas Water Well Contractor's License No. 549 This Water Well Record was completed on (mo/day/yr) 4/13/98 under the business name of J & R Drilling Services, Inc. by (signature) Jon Carlson											
INSTRUCTIONS: Use typewriter or ball point pen. PLEASE PRESS FIRMLY and PRINT clearly. Please fill in blanks, underline or circle the correct answers. Send top three copies to Kansas Department of Health and Environment, Bureau of Water, Topeka, Kansas 66620-0001. Telephone: 913-298-5545. Send one to WATER WELL OWNER and retain one for your records.											