

USE TYPEWRITER OR BALL POINT PEN-PRESS FIRMLY, PRINT CLEARLY.


WATER WELL RECORD  
KSA 82a-1201-1215

Kansas Department of Health and Environment-Division of Environment  
(Water well Contractors)  
Topeka, Kansas 66620

SW-SE 1/4 - NE 1/4 ADC

1. Location of well: County **Doniphan** Fraction ~~NE 1/4 SW 1/4 NE 1/4~~ Section number **14** Township number **T 3 S R 21** Range number **EW**

2. Distance and direction from nearest town or city: **2 miles west and 1 mile north of Blair, Kansas**  
Street address of well location if in city:  
3. Owner of well: **Gerry Wiedmer**  
R.R. or street: **RR 2**  
City, state, zip code: **Troy, Kansas 66087**

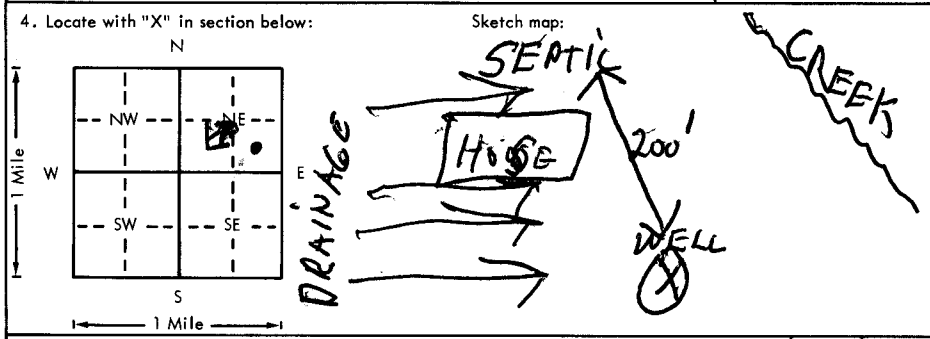

6. Bore hole dia. **36** in. Completion date **6/8/78**  
Well depth **56** Bore hole is **42** to 11  
7. Cable tool  Rotary  Driven  Dug  
 Hollow rod  Jetted  Bored  Reverse rotary  
8. Use:  Domestic  Public supply  Industry  
 Irrigation  Air conditioning  Stock  
 Lawn  Oil field water  Other  
9. Casing: Material **concrete** Above or below  
Threading  Welded  Surface **26** in.  
RMP  PVC  Weight **200** lbs./ft.  
Dia. **30** in. to **56** ft. depth Wall Thickness: inches or  
Dia.  in. to  ft. depth Gage No. **2"**

5. Type and color of material	From	To
Black topsoil	0	2
Fine brown windblown	2	6
Hard brownish clay	6	14
Same, except very hard	14	21
Light yellow clay with chalk or calcium	21	36
Pea-size gravel, bearing some water	36	39
Blue, gray shale, gets harder the deeper you go	39	55
Loose Limestone	55	56
Solid Limestone	56	

10. Screen: Manufacturer's name \_\_\_\_\_  
Type **None** Dia. \_\_\_\_\_  
Slot/gauze \_\_\_\_\_ Length \_\_\_\_\_  
Set between \_\_\_\_\_ ft. and \_\_\_\_\_ ft.  
\_\_\_\_\_ ft. and \_\_\_\_\_ ft.  
Gravel pack?  Size range of material \_\_\_\_\_  
11. Static water level: \_\_\_\_\_ mo./day/yr.  
**37** ft. below land surface Date **6/8/78**  
12. Pumping level below land surfaces:  
**6** ft. after **2** hrs. pumping **8** g.p.m.  
\_\_\_\_\_ ft. after \_\_\_\_\_ hrs. pumping \_\_\_\_\_ g.p.m.  
Estimated maximum yield **1 1/2 - 3** g.p.m.  
13. Water sample submitted: \_\_\_\_\_ mo./day/yr.  
 Yes  No Date \_\_\_\_\_  
14. Well head completion:  
 Pitless adapter \_\_\_\_\_ Inches above grade  
15. Well grouted?   
With:  Neat cement  Bentonite  Concrete  
Depth: From **0** ft. to **11** ft.  
16. Nearest source of possible contamination:  
ft. **200** Direction **North** Type **Septic**  
Well disinfected upon completion?  Yes  No  
17. Pump:  Not installed  
Manufacturer's name \_\_\_\_\_  
Model number \_\_\_\_\_ HP \_\_\_\_\_ Volts \_\_\_\_\_  
Length of drop pipe \_\_\_\_\_ ft. capacity \_\_\_\_\_ g.p.m.  
Type:  
 Submersible  Turbine  
 Jet  Reciprocating  
 Centrifugal  Other

18. Elevation: **1005**  
Topography:  
 Hill  
 Slope  
 Upland  
 Valley  
19. Remarks: **Concrete slab & vent will be installed by customer. He knows and understands this is a regulation.**  
**x Mrs. Gerry Wiedmer**

20. Water well contractor's certification:  
This well was drilled under my jurisdiction and this report is true to the best of my knowledge and belief.  
**Popplewell Well Boring 32**  
Business name \_\_\_\_\_ License No. \_\_\_\_\_  
Address **Amity, MO 64422**  
Signed **Gerry Popplewell** Date **6/15/78**  
Authorized representative

Forward the white, blue and pink copies to the Department of Health and Environment

Form WWC-5

BR = 966 ∇ = 968