

USE TYPEWRITER OR BALL POINT PEN-PRESS FIRMLY, PRINT CLEARLY.

WATER WELL RECORD  
KSA 82a-1201-1215


Kansas Department of Health and Environment-Division of Environment (Water well Contractors) Topeka, Kansas 66620

BDA

15

1. Location of well: County Donaghin Fraction NE SE NW Section number 0 15 Township number T 3 S Range number R 22 E

2. Distance and direction from nearest town or city: 2 1/2 N + 1 3/4 E  
Street address of well location if in city: WATHENA, KS  
3. Owner of well: Martin Marietta  
R.R. or street: 1305 W 42nd  
City, state, zip code: Topeka, KS

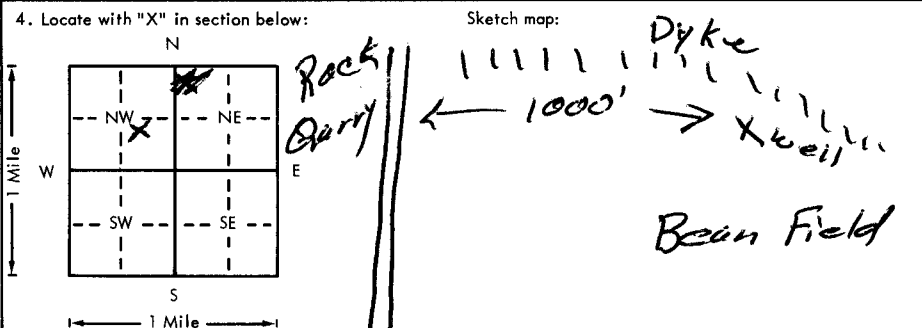

6. Bore hole dia. 14 in. Completion date 6-11-77  
Well depth 63 ft.  
7.  Rotary  Driven  Aug  
 Hollow rod  Jetted  Bored  Reverse rotary  
8. Use:  Domestic  Public supply  Industry  
 Irrigation  Air conditioning  Stock  
 Lawn  Oil field water  Other  
9. Casing: Material Steel Height: Above or below  
Threaded  Welded  Surface 24 in.  
RMP  PVC  Weight          lbs./ft.  
Dia. 8 in. to 63 ft. depth Wall Thickness: inches or  
Dia.          in. to          ft. depth gage No. 179 MHC

5. Type and color of material	From	To
<u>Silty Top Soil</u>	<u>0</u>	<u>6</u>
<u>Blue Clay</u>	<u>6</u>	<u>12</u>
<u>Gray Silty Sugar Sand</u>	<u>12</u>	<u>51</u>
<u>Gray Coarse Sand</u>	<u>51</u>	<u>52</u>
<u>Med. to large Gravel</u>	<u>52</u>	<u>61</u>
<u>Gray Shale</u>	<u>61</u>	<u>63</u>

10. Screen: Manufacturer's name Davis  
Type Stainless Steel Dia. 8"  
Slot/gauze 10/20 Length 8  
Set between 53 ft. and 61 ft.  
         ft. and          ft.  
Gravel pack? yes Size range of material 4 x 5  
11. Static water level: 35 ft. below land surface Date 6-11-77 mo./day/yr.  
12. Pumping level below land surfaces: At test  
         ft. after          hrs. pumping          g.p.m.  
         ft. after          hrs. pumping          g.p.m.  
Estimated maximum yield 100-300 g.p.m.  
13. Water sample submitted:          mo./day/yr.  
 Yes  No Date           
14. Well head completion:  
 Pitless adapter          Inches above grade  
15. Well grouted? yes  
With:  Neat cement  Bentonite  Concrete  
Depth: From 0 ft. to 10 ft.  
16. Nearest source of possible contamination: in field  
ft.          Direction          Type           
Well disinfected upon completion?  Yes  No  
17. Pump:          Not installed  
Manufacturer's name JACUZZI  
Model number 356 H3 HP 10 Volts 230  
Length of drop pipe 55 ft. capacity 230 g.p.m.  
Type:  
 Submersible Turbine  Turbine  
 Jet  Reciprocating  
 Centrifugal  Other

18. Elevation: 810'  
Topography:  
 Hill  
 Slope  
 Upland  
 Valley

19. Remarks: Rock Quarry wash water well

20. Water well contractor's certification:  
This well was drilled under my jurisdiction and this report is true to the best of my knowledge and belief.  
STRADER Dalg Co Inc License No. 182  
Business name Horton, KS  
Address           
Signed Dale Robinson Date 6-13-77  
Authorized representative

T 3  
R 22  
E  
L  
L  
N  
W  
M  
A  
I  
N  
E