


DWR

WATER WELL RECORD Form WWC-5 KSA 82a-1212 ID No.

1 LOCATION OF WATER WELL: Fraction SE 1/4 NE 1/4 NE 1/4 Section Number 34 Township Number T 3 S Range Number R 22 E
 County: Doniphan

Distance and direction from nearest town or city street address of well if located within city?
963 Vernon Road, Wathena KS

2 WATER WELL OWNER: Magellan Midstream Partners, LP
 FIRM, St. Address, Box #: One Williams Center, MD 720A Board of Agriculture, Division of Water Resources
 City, State, ZIP Code: Tulsa, OK 74172 Application Number:

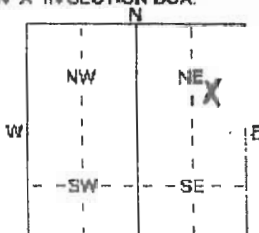3 LOCATE WELL'S LOCATION WITH AN "X" IN SECTION BOX:

 4 DEPTH OF COMPLETED WELL: 20.5 ft. ELEVATION:
 Depth(s) Groundwater Encountered 1 _____ ft. 2 _____ ft. 3 _____ ft.
 WELL'S STATIC WATER LEVEL _____ ft. below land surface measured on (m/d/y):
 Pump test data: Well water was _____ ft. after _____ hours pumping _____ gpm
 Est. Yield _____ gpm: Well water was _____ ft. after _____ hours pumping _____ gpm
 WELL WATER TO BE USED AS:
 1 Domestic 2 Irrigation 3 Feedlot 4 Industrial 5 Public water supply 6 Oil field water supply 7 Domestic (lawn & garden) 8 Air conditioning 9 Dewatering 10 Monitoring well 11 Injection well 12 Other (Specify below)

5 TYPE OF BLANK CASING USED:
 1 Steel 2 PVC 3 RMP (SR) 4 ABS 5 Wrought iron 6 Concrete tile 7 Fiberglass 8 Concrete tile 9 Other (specify below)
 Casing joints: Threaded Glued _____ Clamped _____
 Blank casing diameter _____ in. to _____ ft. Dia _____ in. to _____ ft. Dia _____ in. to _____ ft. Dia
 Casing height above land surface _____ in. weight _____ lbs./ft. Wall thickness or gauge No. _____
 TYPE OF SCREEN OR PERFORATION MATERIAL:
 1 Steel 2 Brass 3 Stainless Steel 4 Galvanized Steel 5 Fiberglass 6 Concrete tile 7 PVC 8 RMP (SR) 9 ABS 10 Asbestos-Cement 11 Other (Specify) 12 None used (open hole)
 SCREEN OR PERFORATION OPENINGS ARE:
 1 Continuous slot 2 Louvered shutter 3 Mill slot 4 Key punched 5 Gauzed wrapped 6 Wire wrapped 7 Torch cut 8 Sew out 9 Drilled holes 11 None (open hole) 10 Other (specify) _____ ft.
 SCREEN-PERFORATED INTERVALS: From 1.0 ft. to 2.0 ft. From _____ ft. to _____ ft.
 GRAVEL PACK INTERVALS: From 8.0 ft. to 20.3 ft. From _____ ft. to _____ ft.

6 GROUT MATERIAL: 1 Neat cement 2 Cement grout 3 Bentonite 4 Other _____
 Grout intervals: From 7 ft. to 0 ft. From _____ ft. to _____ ft. From _____ ft. to _____ ft.
 What is the nearest source of possible contamination:
 1 Septic tank 2 Sewer lines 3 Watertight sewer lines 4 Lateral lines 5 Cess pool 6 Seepage pit 7 Pit privy 8 Sewage lagoon 9 Feedyard 10 Livestock pens 11 Fuel storage 12 Fertilizer storage 13 Insecticide storage 14 Abandoned water well 15 Oil well/Gas well 16 Other (specify below) _____


Direction from well? _____ How many feet? _____

FROM	TO	LITHOLOGIC LOG	FROM	TO	PLUGGING INTERVALS
0	1.5	Gravel Hard Pack	0	2	Concrete
1.5	2.5	Silt, Fine Gray brown, red stain	2	8	3/4" Bentonite Chips
2.5	9.0	Silt, Fine, dark Gray mud (Oden)			
9	19	Sand, very fine Gray to black (Oden)			
19	20	Clay, dark Gray soft mud very Plastic			

RECEIVED
 AUG 20 2004
 BUREAU OF WATER

7: CONTRACTOR'S OR LANDOWNER'S CERTIFICATION: This water well was (1) constructed, (2) reconstructed, or (3) plugged under my jurisdiction and was completed on (m/d/y): 7/16/04 and this record is true to the best of my knowledge and belief. Kansas Water Well Contractor's License No. 725 This Water Well Record was completed on (m/d/y): 8/13/04
 under the business name of SABERPROBE By (signature) Thomas R. Peyton

INSTRUCTIONS: Use typewriter or ball point pen. PLEASE PRESS FIRMLY and PRINT clearly. Place one blank, undated or dated the entire answer. Send two copies to Kansas Department of Health and Environment, Bureau of Water, Geology Section 1000 SW Jackson St., Suite 429 Topeka, Kansas 66612-1387. Telephone 786-295-8522. Send one to WATER WELL OWNER and retain one for your records. Fee of \$8.00 for each constructed well.

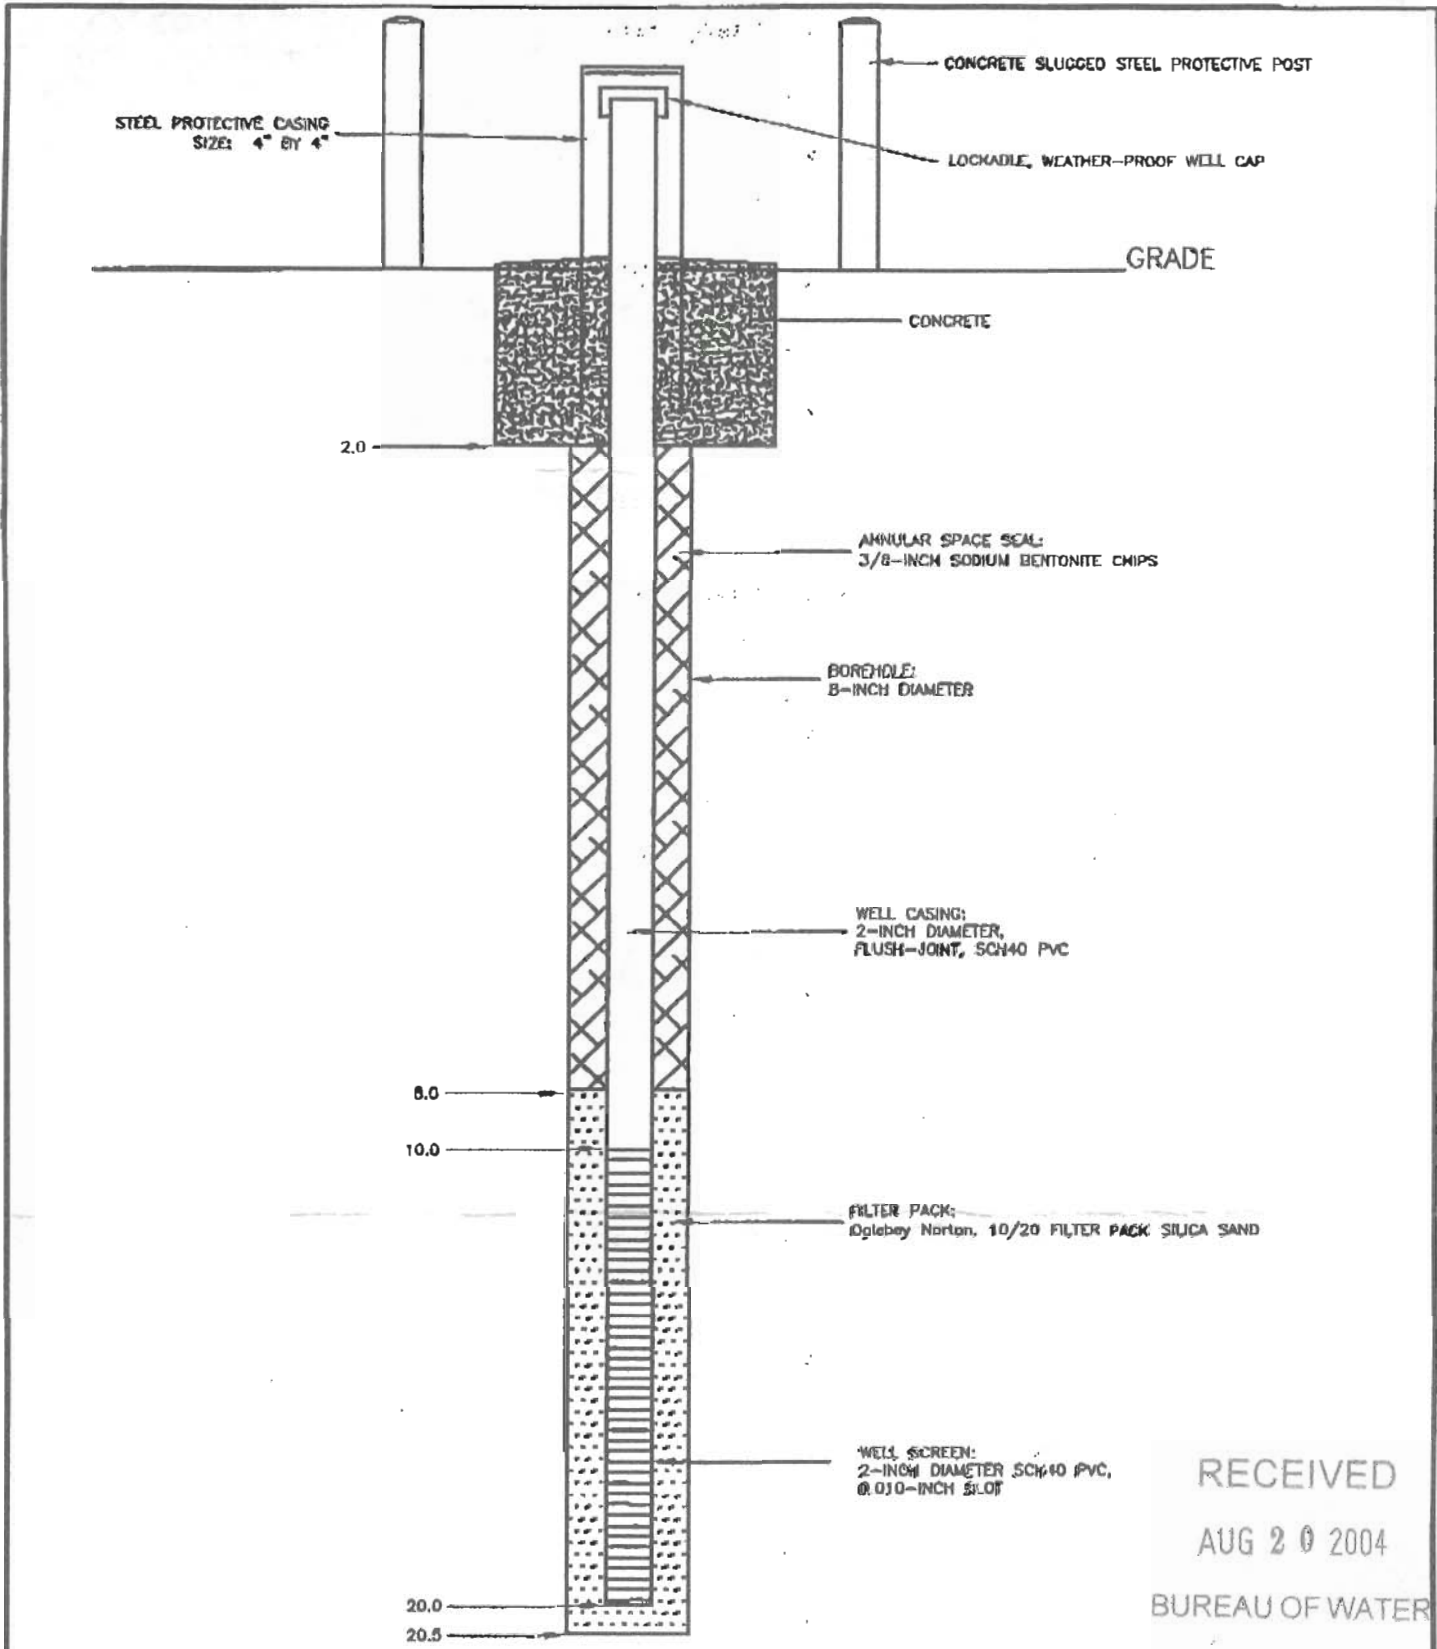

RECEIVED
 AUG 20 2004
 BUREAU OF WATER

NOT TO SCALE

DATE	REVISED

Prepared By:
LEUGETTE, BRASHEARS & GRAHAM, INC.
 Professional Ground-Water and Environmental Services
 North Kansas City Office
 2109 Burlington
 North Kansas City, Mo 64116
 (816) 421-7788

MAGELLAN PIPELINE COMPANY
 ST. JOSEPH TERMINAL,
 WATHENA, KANSAS

CONSTRUCTION DIAGRAM FOR MW04-05

FILE: MW04-05.dwg | DATE: JULY 16, 2004 | MW04-05

Received Time-Aug. 9. - 1:19PM