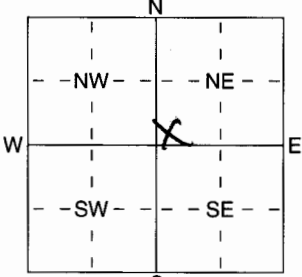


1 LOCATION OF WATER WELL: Fraction SW 1/4 SW 1/4 NE 1/4 Section Number 36 Township Number T 03 S Range Number R 22 EW
 County: Douglas

Distance and direction from nearest town or city street address of well if located within city?
2009 Roseport Road, Elwood

2 WATER WELL OWNER: Texton, Inc.
 RR#, St. Address, Box # : 100 Virginia Center Parkway Board of Agriculture, Division of Water Resources
 City, State, ZIP Code : Providence, RI 02903 Application Number: —

3 LOCATE WELL'S LOCATION WITH AN "X" IN SECTION BOX:  4 DEPTH OF COMPLETED WELL 21.33 ft. ELEVATION: 814.86
 Depth(s) Groundwater Encountered 1 17.42 ft. 2 — ft. 3 — ft.
 WELL'S STATIC WATER LEVEL 17.42 ft. below land surface measured on mo/day/yr 01/27/05
 Pump test data: Well water was — ft. after — hours pumping — gpm
 Est. Yield — gpm: Well water was — ft. after — hours pumping — gpm
 WELL WATER TO BE USED AS: 5 Public water supply 8 Air conditioning 11 Injection well
 1 Domestic 3 Feedlot 6 Oil field water supply 9 Dewatering 12 Other (Specify below)
 2 Irrigation 4 Industrial 7 Domestic (lawn & garden) Monitoring well MW-9
 Was a chemical/bacteriological sample submitted to Department? Yes — No ; If yes, mo/day/yr sample was submitted
 Water Well Disinfected? Yes — No NA

5 TYPE OF BLANK CASING USED: 5 Wrought iron 8 Concrete tile CASING JOINTS: Glued — Clamped —
 1 Steel 3 RMP (SR) 6 Asbestos-Cement 9 Other (specify below) Welded —
 PVC 4 ABS 7 Fiberglass — Threaded
 Blank casing diameter 2 in. to 11 ft. Dia — in. to — ft. Dia — in. to — ft.
 Casing height above land surface -0.57 in., weight — lbs./ft. Wall thickness or gauge No. Sch. 40
 TYPE OF SCREEN OR PERFORATION MATERIAL: PVC 10 Asbestos-Cement
 1 Steel 3 Stainless Steel 5 Fiberglass 8 RMP (SR) 11 Other (Specify) —
 2 Brass 4 Galvanized Steel 6 Concrete tile 9 ABS 12 None used (open hole)
 SCREEN OR PERFORATION OPENINGS ARE: 5 Gauzed wrapped 8 Saw cut 11 None (open hole)
 1 Continuous slot Mill slot 6 Wire wrapped 9 Drilled holes
 2 Louvered shutter 4 Key punched 7 Torch cut 10 Other (specify) — ft.
 SCREEN-PERFORATED INTERVALS: From 21 ft. to 11 ft. From — ft. to — ft.
 From — ft. to — ft. From — ft. to — ft.
 GRAVEL PACK INTERVALS: From 23 ft. to 10.5 ft. From — ft. to — ft.
 From — ft. to — ft. From — ft. to — ft.

6 GROUT MATERIAL: 1 Neat cement 2 Cement grout Bentonite 4 Other —
 Grout Intervals: From 10.5 ft. to 2 ft. From — ft. to — ft. From — ft. to — ft.
 What is the nearest source of possible contamination:
 1 Septic tank 4 Lateral lines 7 Pit privy Fuel storage 10 Livestock pens 14 Abandoned water well
 2 Sewer lines 5 Cess pool 8 Sewage lagoon 12 Fertilizer storage 15 Oil well/Gas well
 3 Watertight sewer lines 6 Seepage pit 9 Feedyard 13 Insecticide storage 16 Other (specify below)
 Direction from well? NW How many feet? 90

FROM	TO	LITHOLOGIC LOG	FROM	TO	PLUGGING INTERVALS
0	1	Asphalt			
1	4	silty clay (CL)			
4	15	silt/very fine sand (ML)			
15	23	fine sand (SM)			

7 CONTRACTOR'S OR LANDOWNER'S CERTIFICATION: This water well was constructed, reconstructed, or plugged under my jurisdiction and was completed on (mo/day/year) 01/26/05 and this record is true to the best of my knowledge and belief. Kansas Water Well Contractor's Licence No 650 This Water Well Record was completed on (mo/day/yr) 03/04/05 under the business name of Deffenbaugh Field Services by signature [Signature]