


Revised

WATER WELL RECORD

Form WWC-5

Division of Water Resources App. No.

1 LOCATION OF WATER WELL: County: Doniphan, Fraction SW 1/4 SE 1/4 NW 1/4 SW 1/4, Section Number 27, Township No. T 3 S, Range Number R 22 E W. Street/Rural Address of Well Location: Fastgas N Snax 2214 US Highway 36 66090 Wathena, KS 66090. Global Positioning System (GPS) information: Latitude: 39.759096, Longitude: 94.942736, Elevation: 823.24. 2 WATER WELL OWNER: St. Joe Petroleum Co. RR#, Street Address, Box #: PO Box 3067 City, State, ZIP Code: St. Joseph, MO 64503. Collection Method: Digital Map/Photo, Land Survey. Est. Accuracy: <3 m.

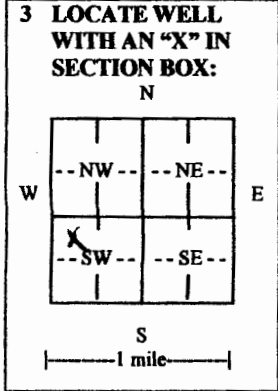

3 LOCATE WELL WITH AN 'X' IN SECTION BOX: N, W, E, S, 1 mile. 4 DEPTH OF COMPLETED WELL 20 ft. Depth(s) Groundwater Encountered (1) 11.5 ft. (2) N/A (3) N/A. WELL'S STATIC WATER LEVEL: 14.3 ft. below land surface measured on mo/day/yr. 11/21/12. Pump test data: Well water was N/A ft. after N/A hours pumping. N/A gpm. EST. YIELD: N/A gpm. Well water was N/A ft. after N/A hours pumping. N/A gpm. Bore Hole Diameter 8.25 in. to 20 ft. and N/A in. to N/A ft. WELL WATER TO BE USED AS: Monitoring well MW-9. Was a chemical/bacteriological sample submitted to Department? No. If yes, mo/day/yr sample was submitted N/A. Water well disinfected? No.

5 TYPE OF CASING USED: PVC. CASING JOINTS: Threaded. Casing diameter 2 in. to 20 ft., Diameter N/A in. to N/A ft., Diameter N/A in. to N/A ft. Casing height above land surface 0 in., Weight N/A lbs./ft., Wall thickness or gauge No. Schedule 40. TYPE OF SCREEN OR PERFORATION MATERIAL: PVC. SCREEN OR PERFORATION OPENINGS ARE: Mill slot. SCREEN-PERFORATED INTERVALS: From 10 ft. to 20 ft., From N/A ft. to N/A ft., From N/A ft. to N/A ft. GRAVEL PACK INTERVALS: From 8 ft. to 20 ft., From N/A ft. to N/A ft., From N/A ft. to N/A ft.

6 GROUT MATERIAL: Bentonite. Grout Intervals: From 2 ft. to 8 ft., From N/A ft. to N/A ft., From N/A ft. to N/A ft. What is the nearest source of possible contamination: Fuel storage. Direction from well Southeast, Distance from well <50 feet.

Table with columns: FROM, TO, LITHOLOGIC LOG, FROM, TO, LITHO. LOG (cont.) or PLUGGING INTERVALS. Rows describe geological layers from 0 to 20 feet depth.

7 CONTRACTOR'S OR LANDOWNER'S CERTIFICATION: This water well was constructed, reconstructed, or plugged under my jurisdiction and was completed on (mo/day/year) 11/21/2012 and this record is true to the best of my knowledge and belief. Kansas Water Well Contractor's License No. 759. This Water Well Record was completed on (mo/day/year) 12/2/2012 under the business name of RAZEK Environmental, LLC by (signature) [Signature].

INSTRUCTIONS: Use typewriter or ball point pen. PLEASE PRESS FIRMLY and PRINT clearly. Please fill in blanks and check the correct answers. Send three copies (white, blue, pink) to Kansas Department of Health and Environment, Bureau of Water, Geology Section, 1000 SW Jackson St., Suite 420, Topeka, Kansas 66612-1367. Telephone 785-296-5524. Send one copy to WATER WELL OWNER and retain one for your records. Include fee of \$5.00 for each constructed well. Visit us at http://www.kdheks.gov/waterwell/index.html.

Bureau of Water
Geology Section
1000 SW Jackson St, Ste 420
Topeka, KS 66612-1367




Phone: 785-296-3565
Fax: 785-296-5509
rharper@kdheks.gov
www.kdheks.gov/geo

Robert Moser, MD, Secretary

Department of Health & Environment

Sam Brownback, Governor

November 19, 2012

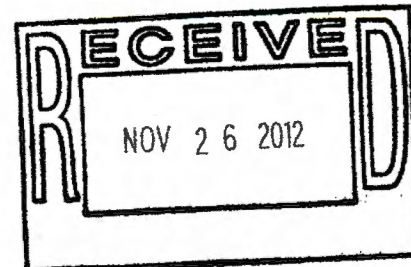

Williams & Company Consulting, Inc.
Katie Williams
9237 Ward Parkway
Suite 220
Kansas City, MO 64114

Re: Waiver request for flush mount monitoring wells for the **Fastgas N Snax, E. Hwy 36, Wathena, Kansas**. Located in the SW $\frac{1}{4}$ of the SE $\frac{1}{4}$ of the NW $\frac{1}{4}$ of the SW $\frac{1}{4}$ of Section 27, Township 3 South, Range 22 East, Doniphan County, Kansas.

Dear Ms. Williams:

In accordance with Kansas Administrative Regulations (K.A.R.) 28-30-9, appealing regulations as stated in Article 30, your request for an exception to **K.A.R. 28-30-6(b)(1) & (e)** for authorization of 5 monitoring well to be constructed less than 12 inches above the **finished ground level**, at the above-mentioned site is hereby granted subject to the following stipulations:

1. Monitoring wells included in this request will be grouted from a maximum of two feet below ground surface to within one foot above the screened section.
2. The wellhead will be encased in an approved water resistant/proof manhole. The manhole will be encased in cement, which is to be domed or sloped to allow drainage away from the manhole, (refer to the attached diagram page 2).
3. The casing of the monitoring well will be sealed with an approved watertight lockable monitoring well caps (refer to the attached diagram).
4. A copy of this KDHE letter, approving your request for waiver of **K.A.R. 28-30-6(b)(1) & (e)**, will be sent to KDHE attached to the water well record (WWC-5 Form) of the first well drilled under the granted waiver.

If you have any questions, please do not hesitate in giving us a call.

Sincerely,



