

USE TYPEWRITER OR BALL POINT PEN - PRESS FIRMLY, PRINT CLEARLY.

WATER WELL RECORD
KSA 82a-1201-1215


T	R	EW	sec	1/4	1/4	1/4	No.
---	---	----	-----	-----	-----	-----	-----

Kansas State Dept. Of Health
(Water Well Contractors)
Forbes-Bldg. 740
Topeka, Kansas 66620

old shaped section

1- Location of well: County <u>Doniphan</u>	Township name	Fraction NE 1/4 <u>SW 1/4 - NE 1/4 - NW 1/4</u>	Section number <u>32</u>	Town number <u>3</u>	Range number <u>23</u>
--	---------------	---	-----------------------------	-------------------------	---------------------------

Distance and direction from nearest town or city: <u>1/4 E.</u>	3 Owner of well: <u>MORAN PAVING</u>
Street address of well location if in city: <u>Elwood, KS.</u>	Address: <u>Elwood, KS</u>

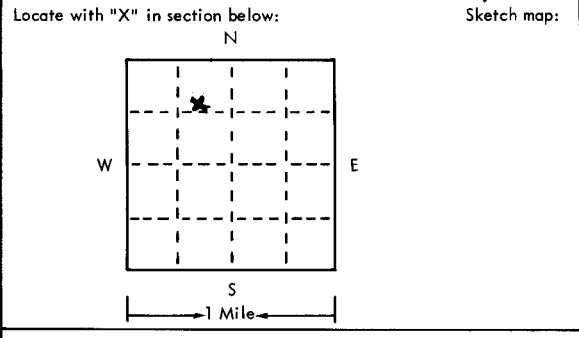


4 Well depth: 62 ft. Date of completion 9-18-75
Well diameter 12 in.

5 Cable tool Rotary Driven Dug
 Hollow rod Jetted Bored Reverse rotary

6 Use: Domestic Public supply Industry
 Irrigation Air conditioning Commercial
 Test well Sprinkling Rock Dr.

7 Casing: Material Steel Height: above/below _____
Threaded Welded Surface 24 in.
Diam. Weight 28.97 lbs./ft.
___ in. to ___ ft. depth! Drive shoe? Yes No
___ in. to ___ ft. depth!

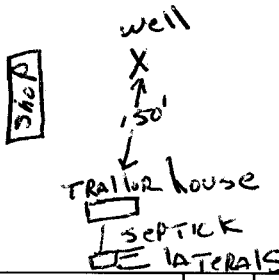

2	Type and color of material	From	To
	Top soil	0	4
	Brown clay	4	40
	Fine sand	40	55
	Coarse sand	55	57
	Coarse sand + pea gravel	57	62
(use a second sheet if needed)			

8 Screen: Manufacturer Johnson
Type Stainless Dia. 6"
Slot/groove 60 Length 5'
Set between 57 ft. and 62 ft.
Fittings:
Gravel pack Yes No Size range of material 4x4

9 Static water level: NOT MEASURED
36 ft. below land surface Date 9-18-75 MUC

10 Pumping level below land surfaces: AIR TEST
___ ft. after ___ hrs. pumping ___ g.p.m.
___ ft. after ___ hrs. pumping ___ g.p.m.
Estimated maximum yield 250 g.p.m.

11 Water sample submitted:
 Yes No Date _____

12 Well head completion: Cappped
 Pitless adapter 24 Inches above grade

13 Well grouted? Yes No
 Neat cement Bentonite
Depth: From 0 ft. to 62 ft.

14 Nearest source of possible contamination: _____
ft. 200 Direction S Type Drink
Well disinfected upon completion? Yes No

15 Pump: Not installed
Manufacturer's name _____
Model number _____ HP _____ Volts _____
Length of drop pipe _____ ft. capacity _____ g.m.p.
Type:
 Submersible Turbine
 Jet Reciprocating
 Centrifugal Other

16 Remarks: elevation 810 Owner to install slab.
Topography: Y-unit area Mor R. [unclear]
 Hill
 Slope
 Upland
 Valley

17 Water well contractor's certification:
This well was drilled under my jurisdiction and this report is true to the best of my knowledge and belief.
STRADER DAUG CO Inc 182
Business name _____ License No. _____
Address DEPT MORAN KS
Signed DAUG DALY Date 9-20-75
Authorized representative

3 2 3 E 32 S E NE NW