

Form WWC-5

Division of Water Resources; App. No.

[illegible]

DENNIS L HANDKE

1820 NW 59th Terrace
TOPEKA, KANSAS 66618
785-286-4047 Home
785-286-1990 Fax

Jessica Chapman
Larsen & Associates
1311 E. 25th Street, Suite B
Lawrence, Kansas, 66046

February 11, 2014

RE: Monitor Well Elevation Survey
7th & Vermont along Railroad, Elwood, Kansas

Proj. 15-00C
Dirt & Gravel Company
U4-022-14614

Bench Mark: Railroad spike in power pole 150 feet West of 8th Street on South side of Vermont Street.
Elev: 818.24 North 246 West 2704 (from SE Cor. Sec. 30-3-23E)


MW-1	rim	817.42	South	19	SW1/4,SW1/4,SW1/4,SE1/4
	top pipe	816.85	West	2570	Lat= 39.75539 Long = 94.88319
MW-2	rim	818.02	North	8	SW1/4,SW1/4,SW1/4,SE1/4
	top pipe	817.65	West	2453	Lat= 39.75546 Long = 94.88277
MW-3	rim	817.04	South	169	NW1/4,NW1/4,NW1/4,NE1/4 (Sec. 31-3-23)
	top pipe	816.74	West	2511	Lat= 39.75498 Long = 94.88298
MW-4	rim	815.86	North	81	SE1/4,SE1/4,SE1/4,SW1/4
	top pipe	815.54	West	2648	Lat= 39.75566 Long = 94.88347
MW-5	rim	816.33	North	71	SW1/4,SW1/4,SW1/4,SE1/4
	top pipe	816.00	West	2520	Lat= 39.75564 Long = 94.88301

Lat & Long derived from Wathena 7.5' quad map. NAVD 27

Elevation established from USGS BM N 106.

If you have any questions, please feel free to call me. Thank you for the opportunity to be of service.

February 11, 2014
Dennis L. Handke RLS
LS-786

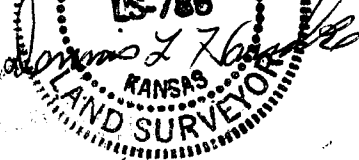

State of Kansas
KDHE/BER Well Tag Form

Dirt and Gravel Company

KDHE Project Code:

U	4	-	0	2	2	-	1	4	6	1	4
---	---	---	---	---	---	---	---	---	---	---	---

Well Tag Number

Well Number

0051041	MW1
0051040	MW2
0051034	MW3
0051039	MW4
0051036	MW5

After completing this form, photocopy it and keep the copy for your files.
Send the original to the address below.

Kansas Department of Health & Environment
Bureau of Environmental Remediation
1000 SW Jackson, Suite 410
Topeka, KS 66612-1367