


1 LOCATION OF WATER WELL: County: WASHINGTON	Fraction SW 1/4 NW 1/4 NE 1/4	Section Number 12	Township Number T 3 S	Range Number R 3 (E/W)
---	----------------------------------	----------------------	--------------------------	---------------------------

Distance and direction from nearest town or city street address of well if located within city?
3/4 mile east of Washington

2 WATER WELL OWNER: 3 MK Pork L.L.C. (Keesecker)
RR#, St. Address, Box #: Rt. 2 Box 97 Board of Agriculture, Division of Water Resources
City, State, ZIP Code: Washington, KS 66968 Application Number:

3 LOCATE WELL'S LOCATION WITH AN "X" IN SECTION BOX:

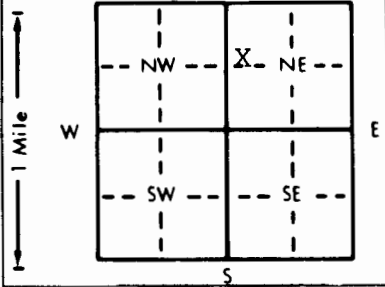

4 DEPTH OF COMPLETED WELL... 120' ft. ELEVATION:
Depth(s) Groundwater Encountered 1... 75' ft. 2... ft. 3... ft.
WELL'S STATIC WATER LEVEL... 62' ft. below land surface measured on mo/day/yr... 2-27-96
Pump test data: Well water was... ft. after... hours pumping... gpm
Est. Yield... 15... gpm: Well water was... ft. after... hours pumping... gpm
Bore Hole Diameter... 8 3/4... in. to... ft., and... in. to... ft.
WELL WATER TO BE USED AS:
5 Public water supply 8 Air conditioning 11 Injection well
1 Domestic 3 Feedlot 6 Oil field water supply 9 Dewatering 12 Other (Specify below)
2 Irrigation 4 Industrial 7 Lawn and garden only 10 Monitoring well
Was a chemical/bacteriological sample submitted to Department? Yes... No... X...; If yes, mo/day/yr sample was submitted
Water Well Disinfected? Yes X No

5 TYPE OF BLANK CASING USED:
1 Steel 3 RMP (SR) 5 Wrought iron 8 Concrete tile CASING JOINTS: Glued... X... Clamped...
2 PVC 4 ABS 6 Asbestos-Cement 9 Other (specify below) Welded...
7 Fiberglass Threaded...
Blank casing diameter... 5" in. to... 0-71... ft., Dia... 5" in. to... 85-119... ft., Dia... in. to... ft.
Casing height above land surface... 24" in., weight... 2.82... lbs./ft. Wall thickness or gauge No... 258

TYPE OF SCREEN OR PERFORATION MATERIAL:
1 Steel 3 Stainless steel 5 Fiberglass 7 PVC 10 Asbestos-cement
2 Brass 4 Galvanized steel 6 Concrete tile 8 RMP (SR) 11 Other (specify) ...
12 None used (open hole)
SCREEN OR PERFORATION OPENINGS ARE:
1 Continuous slot 3 Mill slot 5 Gauzed wrapped 8 Saw cut 11 None (open hole)
2 Louvered shutter 4 Key punched 6 Wire wrapped 9 Drilled holes
7 Torch cut 10 Other (specify) ...

SCREEN-PERFORATED INTERVALS: From... 71... ft. to... 85... ft., From... ft. to... ft.
From... 119... ft. to... 120... ft., From... ft. to... ft.
GRAVEL PACK INTERVALS: From... 24... ft. to... 120... ft., From... ft. to... ft.
From... ft. to... ft., From... ft. to... ft.

6 GROUT MATERIAL: 1 Neat cement 2 Cement grout 3 Bentonite 4 Other ...
Grout Intervals: From... 4... ft. to... 24... ft., From... ft. to... ft., From... ft. to... ft.
What is the nearest source of possible contamination:
1 Septic tank 4 Lateral lines 7 Pit privy 10 Livestock pens 14 Abandoned water well
2 Sewer lines 5 Cess pool 8 Sewage lagoon 11 Fuel storage 15 Oil well/Gas well
3 Watertight sewer lines 6 Seepage pit 9 Feedyard 12 Fertilizer storage 16 Other (specify below)
13 Insecticide storage
Direction from well? NE How many feet? 600'

FROM	TO	LITHOLOGIC LOG	FROM	TO	PLUGGING INTERVALS
0	7	Clay-Brown	52	57	Shale-Red
7	11	Shale-Yellow	57	73	Shale-Grey
11	13	Limestone-Yellow	73	76	Limestone-Gr-Loose
13	16	Shale-Yellow	76	88	Limestone-Grey
16	20	Shale-Grey	88	96	Shale-Grey
20	21	Limestone-Grey	96	104	Limestone-Grey
21	26	Shale-Grey	104	111	Shale-Grey
26	27	Limestone-Grey	111	120	Shale-Red
27	31	Shale-Grey			
31	33	Shale-Red			
33	35	Shale-Grey			
35	37	Limestone-Grey			
37	42	Shale-Grey			
42	47	Limestone-Grey			
47	52	Shale-Grey			

7 CONTRACTOR'S OR LANDOWNER'S CERTIFICATION: This water well was (1) constructed, (2) reconstructed, or (3) plugged under my jurisdiction and was completed on (mo/day/year) 2-27-96 and this record is true to the best of my knowledge and belief. Kansas Water Well Contractor's License No. 182 This Water Well Record was completed on (mo/day/yr) 3-13-96 under the business name of STRADER DRILLING CO., INC. by (signature) Dale Askren