


1 LOCATION OF WATER WELL: Fraction SW 1/4 NW 1/4 NE 1/4 Section Number 12 Township Number T 3 S Range Number R 3 EW

Distance and direction from nearest town or city street address of well if located within city?  
 1/2 mile east of Washington

2 WATER WELL OWNER: 3MK Pork, L.L.C.  
 RR#, St. Address, Box #: 2069 Prairie Rd. Board of Agriculture, Division of Water Resources  
 City, State, ZIP Code: Washington, KS 66968-8620 Application Number:

3 LOCATE WELL'S LOCATION WITH AN "X" IN SECTION BOX:

4 DEPTH OF COMPLETED WELL: 60' ft. ELEVATION:

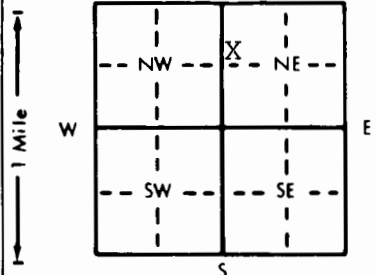

Depth(s) Groundwater Encountered 1. 32' ft. 2. ft. 3. ft.  
 WELL'S STATIC WATER LEVEL 16' ft. below land surface measured on mo/day/yr 12/6/96  
 Pump test data: Well water was ft. after hours pumping gpm  
 Est. Yield 12 gpm: Well water was ft. after hours pumping gpm  
 Bore Hole Diameter 12" in. to ft. and in. to ft.  
 WELL WATER TO BE USED AS: 5 Public water supply 8 Air conditioning 11 Injection well  
 1 Domestic 3 Feedlot 6 Oil field water supply 9 Dewatering 12 Other (Specify below)  
 2 Irrigation 4 Industrial 7 Lawn and garden only 10 Monitoring well  
 Was a chemical/bacteriological sample submitted to Department? Yes No X If yes, mo/day/yr sample was sub-  
 mitted Water Well Disinfected? Yes X No

5 TYPE OF BLANK CASING USED: 5 Wrought iron 8 Concrete tile CASING JOINTS: Glued X Clamped  
 1 Steel 3 RMP (SR) 6 Asbestos-Cement 9 Other (specify below) Welded  
 2 PVC 4 ABS 7 Fiberglass Threaded

Blank casing diameter 5" in. to 0-22 ft. Dia 5" in. to 37-59 ft. Dia in. to ft.  
 Casing height above land surface 24" in. weight 2.82 lbs./ft. Wall thickness or gauge No. 258

TYPE OF SCREEN OR PERFORATION MATERIAL: 7 PVC 10 Asbestos-cement  
 1 Steel 3 Stainless steel 5 Fiberglass 8 RMP (SR) 11 Other (specify)  
 2 Brass 4 Galvanized steel 6 Concrete tile 9 ABS 12 None used (open hole)

SCREEN OR PERFORATION OPENINGS ARE: 5 Gauzed wrapped 8 Saw cut 11 None (open hole)  
 1 Continuous slot 3 Mill slot 6 Wire wrapped 9 Drilled holes  
 2 Louvered shutter 4 Key punched 7 Torch cut 10 Other (specify)

SCREEN-PERFORATED INTERVALS: From 22 ft. to 37 ft. From ft. to ft.  
 From 59 ft. to 60 ft. From ft. to ft.  
 GRAVEL PACK INTERVALS: From 22 ft. to 60 ft. From ft. to ft.  
 From ft. to ft. From ft. to ft.

6 GROUT MATERIAL: 1 Neat cement 2 Cement grout 3 Bentonite 4 Other  
 Grout Intervals: From 0 ft. to 22 ft. From ft. to ft. From ft. to ft.

What is the nearest source of possible contamination:  
 1 Septic tank 4 Lateral lines 7 Pit privy 10 Livestock pens 14 Abandoned water well  
 2 Sewer lines 5 Cess pool 8 Sewage lagoon 11 Fuel storage 15 Oil well/Gas well  
 3 Watertight sewer lines 6 Seepage pit 9 Feedyard 12 Fertilizer storage 16 Other (specify below)  
 13 Insecticide storage creek  
 Direction from well? north How many feet? 50'

FROM	TO	LITHOLOGIC LOG	FROM	TO	PLUGGING INTERVALS
0	6	Top Soil			
6	19	Clay-Brown			
19	23	Fine Sand-Brown			
23	31	Clay-Blue			
31	33	FS-CS-Med-Pea Gravel-Br-Grey			
33	35	Shale-Yellow			
35	37	Limestone-Grey			
37	50	Shale-Grey			
50	52	Limestone-Grey			
52	57	Shale-Grey			
57	60	Shale-Red			

7 CONTRACTOR'S OR LANDOWNER'S CERTIFICATION: This water well was (1) constructed, (2) reconstructed, or (3) plugged under my jurisdiction and was completed on (mo/day/year) 12-06-96 and this record is true to the best of my knowledge and belief. Kansas Water Well Contractor's License No. 182 This Water Well Record was completed on (mo/day/yr) 1-3-97 under the business name of STRADER DRILLING CO., INC. by (signature) Dale Peterson