WATER WELL RECORD Form WWC-5 KSA 82a-1212 ID No. _____

| 1 LOCATION OF WATER WELL: | Fraction | Section Number | Township Number | Range Number |
|---|---|---|---|---|
| County: Washington | NE ¼ NE ¼ NE ¼ | 5 | T 3 S | R 3 (E/W) |

Distance and direction from nearest town or city street address of well if located within city?

3 West & 1 North of Washington

2 WATER WELL OWNER: Kathy Jensen

RR#, St. Address, Box # : 1795 National Rd.

City, State, ZIP Code : Washington, KS 66968

Board of Agriculture, Division of Water Resources Application Number:

3 LOCATE WELL'S LOCATION WITH AN "X" IN SECTION BOX:

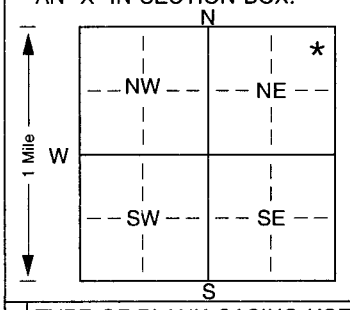


4 DEPTH OF COMPLETED WELL 82 ft. ELEVATION:

Depth(s) Groundwater Encountered 1. ____ ft. 2. ____ ft. 3. 4/19/02 ft.

WELL'S STATIC WATER LEVEL 46 ft. below land surface measured on mo/day/yr 4/19/02

Pump test data: Well water was ____ ft. after ____ hours pumping ____ gpm

Est. Yield 50+ gpm: Well water was ____ ft. after ____ hours pumping ____ gpm

Bore Hole Diameter 10 in. to 82 ft., and ____ in. to ____ ft.

WELL WATER TO BE USED AS: 1 Domestic 2 Irrigation 3 Feedlot 4 Industrial 5 Public water supply 6 Oil field water supply 7 Domestic (lawn & garden) 8 Air conditioning 9 Dewatering 10 Monitoring well 11 Injection well 12 Other (Specify below)

*Was a chemical/bacteriological sample submitted to Department? Yes ____ No *; If yes, mo/day/yrs sample was submitted ____ Water Well Disinfected? Yes * No

5 TYPE OF BLANK CASING USED: 1 Steel 2 PVC 3 RMP (SR) 4 ABS 5 Wrought iron 6 Asbestos-Cement 7 Fiberglass 8 Concrete tile 9 Other (specify below)

CASING JOINTS: Glued * Clamped ____ Welded ____ Threaded ____

Blank casing diameter 5 in. to 62 ft., Dia ____ in. to ____ ft., Dia ____ in. to ____ ft.

Casing height above land surface 18 in., weight 200 lbs./ft. Wall thickness or gauge No. .265

TYPE OF SCREEN OR PERFORATION MATERIAL: 1 Steel 2 Brass 3 Stainless steel 4 Galvanized steel 5 Fiberglass 6 Concrete tile 7 PVC 8 RMP (SR) 9 ABS 10 Asbestos-cement 11 Other (specify) 12 None used (open hole)

SCREEN OR PERFORATION OPENINGS ARE: 1 Continuous slot 2 Louvered shutter 3 Mill slot 4 Key punched 5 Gauzed wrapped 6 Wire wrapped 7 Torch cut 8 Saw cut 9 Drilled holes 10 Other (specify) 11 None (open hole)

SCREEN-PERFORATED INTERVALS: From 62 ft. to 82 ft., From ____ ft. to ____ ft.

From ____ ft. to ____ ft., From ____ ft. to ____ ft.

GRAVEL PACK INTERVALS: From 20 ft. to 82 ft., From ____ ft. to ____ ft.

From ____ ft. to ____ ft., From ____ ft. to ____ ft.

6 GROUT MATERIAL: 1 Neat cement 2 Cement grout 3 Bentonite 4 Other ____

Grout Intervals: From 0 ft. to 20 ft., From ____ ft. to ____ ft., From ____ ft. to ____ ft.

What is the nearest source of possible contamination:

1 Septic tank 2 Sewer lines 3 Watertight sewer lines 4 Lateral lines 5 Cess pool 6 Seepage pit 7 Pit privy 8 Sewage lagoon 9 Feedyard 10 Livestock pens 11 Fuel storage 12 Fertilizer storage 13 Insecticide storage 14 Abandoned water well 15 Oil well/Gas well 16 Other (specify below)

Direction from well? NE How many feet? 150

| FROM | TO | LITHOLOGIC LOG | FROM | TO | PLUGGING INTERVALS |
|---|---|---|---|---|---|
| 0 | 13 | Brown Sandy Clay | | | |
| 13 | 15 | Gray Clay | | | |
| 15 | 62 | Sandstone (Tan & Yellow) | | | |
| 62 | 82 | Sandstone (Orange) | | | |

7 CONTRACTOR'S OR LANDOWNER'S CERTIFICATION: This water well was (1) constructed, (2) reconstructed, or (3) plugged under my jurisdiction and was completed on (mo/day/year) 4/19/02 and this record is true to the best of my knowledge and belief. Kansas Water Well Contractor's Licence No. 518 This Water Well Record was completed on (mo/day/yr) 4/22/02 under the business name of Blue Valley Drilling by (signature) [signature]

INSTRUCTIONS: Use typewriter or ball point pen. *PLEASE PRESS FIRMLY* and *PRINT* clearly. Please fill in blanks, underline or circle the correct answers. Send top three copies to Kansas Department of Health and Environment, Bureau of Water, Topeka, Kansas 66620-0001. Telephone 785-296-5524. Send one to WATER WELL OWNER and retain one for your records. Fee of $5.00 for each constructed well.