


1 LOCATION OF WATER WELL: Fraction NE 1/4 NE 1/4 NW 1/4 Section Number 34 Township Number T 3 S Range Number R 3E E/W
 County: Washington

Distance and direction from nearest town or city street address of well if located within city?
5 miles north of Linn

2 WATER WELL OWNER: Phil Hiesterman
 RR#, St. Address, Box # : 1569 10th Rd Board of Agriculture, Division of Water Resources
 City, State, ZIP Code : Linn, Kansas 66953 Application Number:

3 LOCATE WELL'S LOCATION WITH AN "X" IN SECTION BOX: DEPTH OF COMPLETED WELL 100 ft. ELEVATION:
 Depth(s) Groundwater Encountered 1 ft. 2 ft. 3 ft.
 WELL'S STATIC WATER LEVEL 1.5 ft. below land surface measured on mo/day/yr 1-31-05
 Pump test data: Well water was ft. after hours pumping gpm
 Est. Yield 1.0 gpm: Well water was ft. after hours pumping gpm
 WELL WATER TO BE USED AS: 5 Public water supply 8 Air conditioning 11 Injection well
 1 Domestic 3 Feedlot 6 Oil field water supply 9 Dewatering 12 Other (Specify below)
 2 Irrigation 4 Industrial 7 Domestic (lawn & garden) 10 Monitoring well
 Was a chemical/bacteriological sample submitted to Department? Yes No X...; If yes, mo/day/yr sample was submitted
 Water Well Disinfected? Yes X No

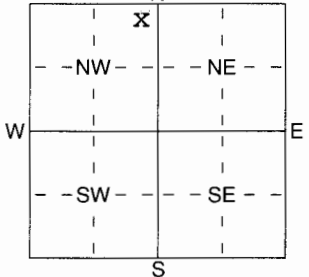

5 TYPE OF BLANK CASING USED: 5 Wrought iron 8 Concrete tile CASING JOINTS: Glued X..... Clamped
 1 Steel 3 RMP (SR) 6 Asbestos-Cement 9 Other (specify below) Welded
 2 PVC 4 ABS 7 Fiberglass Threaded
 Blank casing diameter 5 in. to ft., Dia in. to ft., Dia in. to ft.
 Casing height above land surface 2.4 in., weight 2.82 lbs./ft. Wall thickness or gauge No. .258
 TYPE OF SCREEN OR PERFORATION MATERIAL: 7 PVC 10 Asbestos-Cement
 1 Steel 3 Stainless Steel 5 Fiberglass 8 RMP (SR) 11 Other (Specify)
 2 Brass 4 Galvanized Steel 6 Concrete tile 9 ABS 12 None used (open hole)
 SCREEN OR PERFORATION OPENINGS ARE: 5 Gauzed wrapped 8 Saw cut 11 None (open hole)
 1 Continuous slot 3 Mill slot 6 Wire wrapped 9 Drilled holes
 2 Louvered shutter 4 Key punched 7 Torch cut 10 Other (specify) ft.
 SCREEN-PERFORATED INTERVALS: From 40 ft. to 50 ft., From 90 ft. to 100 ft.
 From ft. to ft., From ft. to ft.
 GRAVEL PACK INTERVALS: From 25 ft. to 100 ft., From ft. to ft.
 From ft. to ft., From ft. to ft.

6 GROUT MATERIAL: 1 Neat cement 2 Cement grout 3 Bentonite 4 Other
 Grout Intervals: From 5 ft. to 25 ft., From ft. to ft., From ft. to ft.
 What is the nearest source of possible contamination:
 1 Septic tank 4 Lateral lines 7 Pit privy 10 Livestock pens 14 Abandoned water well
 2 Sewer lines 5 Cess pool 8 Sewage lagoon 11 Fuel storage 15 Oil well/Gas well
 3 Watertight sewer lines 6 Seepage pit 9 Feedyard 12 Fertilizer storage 16 Other (specify below)
 13 Insecticide storage
 Direction from well? South How many feet? 100'

FROM	TO	LITHOLOGIC LOG	FROM	TO	PLUGGING INTERVALS
0	1	top soil	67	71	limestone grey
		clay brown	71	87	shale grey
1	18	clay brown	87	91	shale brown
18	29	clay grey brown	91	92	limestone grey
29	35	clay dark grey	92	98	shale grey
35	37	clay grey silty	98	100	limestone grey
37	40	loose chert			
40	44	course sand grey brown			
44	46	limestone grey			
46	52	shale grey			
52	55	limestone grey			
55	57	shale grey			
57	59	limestone grey			
59	67	shale grey			

7 CONTRACTOR'S OR LANDOWNER'S CERTIFICATION: This water well was (1) constructed, (2) reconstructed, or (3) plugged under my jurisdiction and was completed on (mo/day/year) 1-31-05 and this record is true to the best of my knowledge and belief. Kansas Water Well Contractor's Licence No 182 This Water Well Record was completed on (mo/day/yr) 4-4-05 under the business name of Strader Drilling Co., INC. by (signature) Jim Strader