


1 LOCATION OF WATER WELL: County: Washington Fraction: SW 1/4 SW 1/4 SW 1/4 Section Number: 1 Township Number: 3 Range Number: 3 EW

Distance and direction from nearest town or city street address of well if located within city?
700 B STREET Washington, Kansas

2 WATER WELL OWNER: Leisler Oil Global Positioning Systems (decimal degrees, min. of 4 digits)
 RR#, St. Address, Box #: 635 W. Crawford Latitude: 39.8144
 City, State ZIP Code: Clay Center KS Longitude: -97.01744
67432-2337 Elevation: 1321.34
 Datum: _____ Data Collection Method: Survey

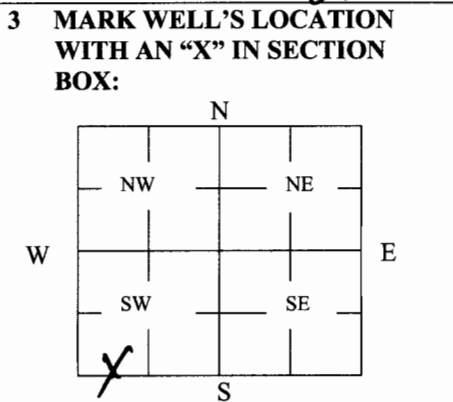

4 DEPTH OF WELL 26.93 ft.
 WELL'S STATIC WATER LEVEL < 26.93 ft DRY
 WELL WAS USED AS:
 1 Domestic 2 Irrigation 3 Feedlot 4 Industrial 5 Public Water Supply 6 Oil Field Water Supply 7 Domestic (Lawn & Garden) 8 Air Conditioning 9 Dewatering 10 Monitoring 11 Injection Well 12 Other _____
 Was a chemical/bacteriological sample submitted to Department? Yes _____ No X

5 TYPE OF BLANK CASING USED:
 1 Steel 2 PVC 3 RMP (SR) 4 ABS 5 Wrought 6 Asbestos-Cement 7 Fiberglass 8 Concrete Tile 9 Other (Specify below) _____
 Blank casing diameter 2 in. Was casing pulled? Yes X No _____ If yes, how much 9'
 Casing height above or below land surface 9' in.

6 GROUT PLUG MATERIAL: 1 Neat cement 2 Cement grout 3 Bentonite 4 Other _____
 Grout Plug Intervals: From 26.93 ft. to 1 ft., From _____ ft. to _____ ft., From _____ to _____ ft.

What is the nearest source of possible contamination:
 1 Septic tank 2 Sewer lines 3 Watertight sewer lines 4 Lateral lines 5 Cess pool 6 Seepage pit 7 Pit privy 8 Sewage lagoon 9 Feedyard 10 Livestock pens 11 Fuel Storage 12 Fertilizer storage 13 Insecticide storage 14 Abandoned water well 15 Oil well/Gas well 16 Other (specify below) _____
 Direction from well? NW 300
 How many feet? 300

FROM	TO	PLUGGING MATERIALS	FROM	TO	PLUGGING MATERIALS
<u>26.93</u>	<u>1</u>	<u>BENTONITE CHIPS</u>			
<u>1</u>		<u>SURFACE GRAVEL + ROCKS</u>			

7 CONTRACTOR'S OR LANDOWNER'S CERTIFICATION: This water well was plugged under my jurisdiction and was completed on (mo/day/year) 10/27/09 and this record is true to the best of my knowledge and belief. Kansas Water Well Contractor's License No. _____. This Water Well Record was completed on (mo/day/year) 11/6/09 under the business name of Tank Management Services by (signature) [Signature]

INSTRUCTIONS: Use typewriter or ballpoint pen. Please press firmly and print clearly. Please fill in blanks, underline or circle the correct answers. Send top three copies to Kansas Department of Health and Environment, Bureau of Water, Geology Section, 1000 SW Jackson St., Ste. 420, Topeka, Kansas 66612-1367. Telephone: 785/296-5522. Send one to Water Well Owner and retain one for your records. Visit us at <http://www.kdheks.gov/geo/waterwells>.

E 7th St / B St Exit Photo



To report an inappropriate image, exit and click the photo icon.

Google

Eye alt 1326 ft

RECEIVED
JAN 3 2010
KS GEO SURVEY