

MW 12

WATER WELL PLUGGING RECORD Form WWC-5P KSA 82a-1212 ID NO. [ ]


1 LOCATION OF WATER WELL: County: Washington Fraction SW 1/4 SW 1/4 SW 1/4 Section Number 1 Township Number 3 Range Number 3 EW

Distance and direction from nearest town or city street address of well if located within city?

Hwy 15 + 36

2 WATER WELL OWNER: Leisler Oil Global Positioning Systems (decimal degrees, min. of 4 digits)  
RR#, St. Address, Box #: 635 W. Crawford Latitude: 39.81441  
City, State ZIP Code: Clay Center, KS Longitude: -97.04744  
67432-2337 Elevation: 1315.93  
Datum: \_\_\_\_\_ Data Collection Method: Survey

3 MARK WELL'S LOCATION WITH AN "X" IN SECTION BOX:

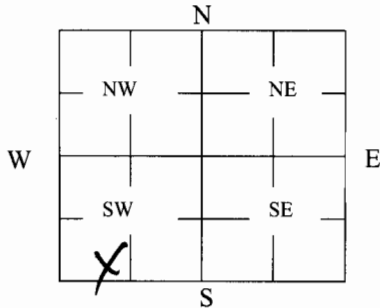

4 DEPTH OF WELL 31.30 ft.

WELL'S STATIC WATER LEVEL 1293.93 ft

WELL WAS USED AS:

- 1 Domestic
- 2 Irrigation
- 3 Feedlot
- 4 Industrial
- 5 Public Water Supply
- 6 Oil Field Water Supply
- 7 Domestic (Lawn & Garden)
- 8 Air Conditioning
- 9 Dewatering
- 10 Monitoring
- 11 Injection Well
- 12 Other \_\_\_\_\_

Was a chemical/bacteriological sample submitted to Department? Yes \_\_\_\_\_ No X

5 TYPE OF BLANK CASING USED:  
1 Steel    2 PVC    3 RMP (SR)    4 ABS    5 Wrought    6 Asbestos-Cement    7 Fiberglass    8 Concrete Tile    9 Other (Specify below) \_\_\_\_\_

Blank casing diameter 2 in. Was casing pulled? Yes \_\_\_\_\_ No X If yes, how much \_\_\_\_\_  
Casing height above or below land surface 4" in.

6 GROUT PLUG MATERIAL: 1 Neat cement    2 Cement grout    3 Bentonite    4 Other \_\_\_\_\_

Grout Plug Intervals: From 31.3 ft. to 0 ft., From \_\_\_\_\_ ft. to \_\_\_\_\_ ft., From \_\_\_\_\_ to \_\_\_\_\_ ft.

What is the nearest source of possible contamination:  
1 Septic tank    2 Sewer lines    3 Watertight sewer lines    4 Lateral lines    5 Cess pool  
6 Seepage pit    7 Pit privy    8 Sewage lagoon    9 Feedyard    10 Livestock pens  
11 Fuel Storage    12 Fertilizer storage    13 Insecticide storage    14 Abandoned water well    15 Oil well/Gas well  
16 Other (specify below) \_\_\_\_\_  
Direction from well? W  
How many feet? 80

FROM	TO	PLUGGING MATERIALS	FROM	TO	PLUGGING MATERIALS
<u>31.30</u>	<u>0</u>	<u>Bentonite chips</u>			

7 CONTRACTOR'S OR LANDOWNER'S CERTIFICATION: This water well was plugged under my jurisdiction and was completed on (mo/day/year) \_\_\_\_\_ and this record is true to the best of my knowledge and belief. Kansas Water Well Contractor's License No. \_\_\_\_\_. This Water Well Record was completed on (mo/day/year) 4/19/10 under the business name of Tank Management Services by (signature) [Signature]

INSTRUCTIONS: Use typewriter or ballpoint pen. Please press firmly and print clearly. Please fill in blanks, underline or circle the correct answers. Send top three copies to Kansas Department of Health and Environment, Bureau of Water, Geology Section, 1000 SW Jackson St., Ste. 420, Topeka, Kansas 66612-1367. Telephone: 785/296-5522. Send one to Water Well Owner and retain one for your records. Visit us at <http://www.kdheks.gov/geo/waterwells>.