


1	LOCATION OF WATER WELL:	Fraction	Section Number	Township Number	Range Number
	County: <u>Washington</u>	<u>1/4 NW 1/4 NE 1/4</u>	<u>B1K 22 Sec 02</u>	<u>03</u>	<u>03</u> (EW)

Distance and direction from nearest town or city street address of well if located within city?  
well located 124 E 4th Washington KS

2	WATER WELL OWNER: <u>Richard Miller</u>	RR #, St. Address, Box #: <u>2229 Liberty Rd 66958</u> City, State, ZIP Code: _____ Board of Agriculture, Division of Water Resources Application Number: _____
---	---	--

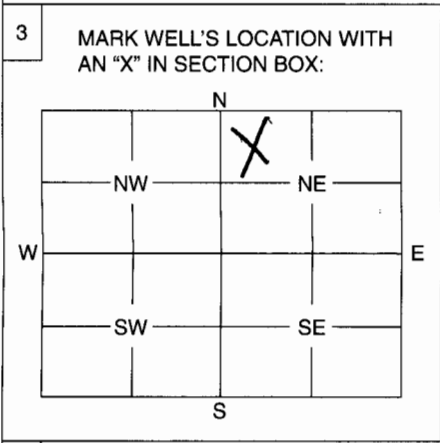

4	DEPTH OF WELL ..... <u>37</u> ..... ft.	WELL'S STATIC WATER LEVEL ..... <u>11</u> ..... ft.												
WELL WAS USED AS:														
<table style="width:100%; border:none;"> <tr> <td style="width:33%;">1 Domestic</td> <td style="width:33%;">5 Public Water Supply</td> <td style="width:33%;">9 Dewatering</td> </tr> <tr> <td>2 Irrigation</td> <td>6 Oil Field Water Supply</td> <td>10 Monitoring Well</td> </tr> <tr> <td>3 Feedlot</td> <td>7 Domestic (Lawn &amp; Garden)</td> <td>11 Injection Well</td> </tr> <tr> <td>4 Industrial</td> <td>8 Air Conditioning</td> <td>12 Other .....</td> </tr> </table>			1 Domestic	5 Public Water Supply	9 Dewatering	2 Irrigation	6 Oil Field Water Supply	10 Monitoring Well	3 Feedlot	7 Domestic (Lawn & Garden)	11 Injection Well	4 Industrial	8 Air Conditioning	12 Other .....
1 Domestic	5 Public Water Supply	9 Dewatering												
2 Irrigation	6 Oil Field Water Supply	10 Monitoring Well												
3 Feedlot	7 Domestic (Lawn & Garden)	11 Injection Well												
4 Industrial	8 Air Conditioning	12 Other .....												
Was a chemical / bacteriological sample submitted to Department? Yes ..... No .....														
If yes, mo/day/yr sample was submitted .....														
Water Well Disinfected: Yes <input checked="" type="checkbox"/> No .....														

5	TYPE OF BLANK CASING USED:	<table style="width:100%; border:none;"> <tr> <td>1 Steel</td> <td>3 RMP (SR)</td> <td>5 Wrought</td> <td>7 Fiberglass</td> <td><input checked="" type="radio"/> Other (Specify below)</td> </tr> <tr> <td>2 PVC</td> <td>4 ABS</td> <td>6 Asbestos-Cement</td> <td>8 Concrete Tile</td> <td><u>Rock</u></td> </tr> </table>	1 Steel	3 RMP (SR)	5 Wrought	7 Fiberglass	<input checked="" type="radio"/> Other (Specify below)	2 PVC	4 ABS	6 Asbestos-Cement	8 Concrete Tile	<u>Rock</u>
1 Steel	3 RMP (SR)	5 Wrought	7 Fiberglass	<input checked="" type="radio"/> Other (Specify below)								
2 PVC	4 ABS	6 Asbestos-Cement	8 Concrete Tile	<u>Rock</u>								
Blank casing diameter ..... in.		Was casing pulled? Yes ..... No ..... If yes, how much .....										
Casing height above or below land surface ..... in.												

6	GROUT PLUG MATERIAL:	<table style="width:100%; border:none;"> <tr> <td>1 Neat cement</td> <td>2 Cement grout</td> <td><input checked="" type="radio"/> Bentonite</td> <td>4 Other .....</td> </tr> </table>	1 Neat cement	2 Cement grout	<input checked="" type="radio"/> Bentonite	4 Other .....																
1 Neat cement	2 Cement grout	<input checked="" type="radio"/> Bentonite	4 Other .....																			
Grout Plug Intervals: From <u>5</u> ft. to <u>4 1/2</u> ft.,		From ..... ft. to ..... ft., From ..... to .....																				
What is the nearest source of possible contamination:																						
<table style="width:100%; border:none;"> <tr> <td>1 Septic tank</td> <td>6 Seepage pit</td> <td>11 Fuel storage</td> <td>16 Other (specify below)</td> </tr> <tr> <td>2 Sewer lines</td> <td>7 Pit privy</td> <td>12 Fertilizer storage</td> <td>.....</td> </tr> <tr> <td>3 Watertight sewer lines</td> <td>8 Sewage lagoon</td> <td>13 Insecticide storage</td> <td></td> </tr> <tr> <td>4 Lateral lines</td> <td>9 Feedyard</td> <td>14 Abandoned water well</td> <td></td> </tr> <tr> <td>5 Cess pool</td> <td>10 Livestock pens</td> <td>15 Oil well/Gas well</td> <td></td> </tr> </table>			1 Septic tank	6 Seepage pit	11 Fuel storage	16 Other (specify below)	2 Sewer lines	7 Pit privy	12 Fertilizer storage	.....	3 Watertight sewer lines	8 Sewage lagoon	13 Insecticide storage		4 Lateral lines	9 Feedyard	14 Abandoned water well		5 Cess pool	10 Livestock pens	15 Oil well/Gas well	
1 Septic tank	6 Seepage pit	11 Fuel storage	16 Other (specify below)																			
2 Sewer lines	7 Pit privy	12 Fertilizer storage	.....																			
3 Watertight sewer lines	8 Sewage lagoon	13 Insecticide storage																				
4 Lateral lines	9 Feedyard	14 Abandoned water well																				
5 Cess pool	10 Livestock pens	15 Oil well/Gas well																				
Direction from well? .....		How many feet? .....																				

FROM	TO	PLUGGING MATERIALS
<u>37</u>	<u>26</u>	<u>Chlorinated sand</u>
<u>26</u>	<u>5</u>	<u>Subsoil fill</u>
<u>5</u>	<u>4 1/2</u>	<u>Bentonite plug</u>
<u>4 1/2</u>	<u>0</u>	<u>Topsoil</u>

**Original Returned to Sender  
for Correction Date: 5/25/10**

7	CONTRACTOR'S OF LANDOWNER'S CERTIFICATION: This water well was plugged under my jurisdiction and was completed on (mo/day/year) ..... <u>4-22-10</u> ..... and this record is true to the best of my knowledge and belief. Kansas Water Well Contractor's License No. .... This Water Well Record was completed on (mo/day/year) <u>4-22-10</u> under the business name of ..... by (signature) <u>Richard Miller</u> .....
---	---

INSTRUCTIONS: Use typewriter or ball point pen. Please press firmly and print clearly. Please fill in blanks, underline or circle the correct answers. Send top three copies to Kansas Department of Health and Environment, Bureau of Water, Geology Section, 1000 SW Jackson St., Ste. 420, Topeka, Kansas 66612-1367. Telephone: 785/296-5522. Send one to Water Well Owner and retain one for your records.