

Table with 5 columns: LOCATION OF WATER WELL: County: Washington; Fraction: SE 1/4 SW 1/4 NE 1/4; Section Number: 2; Township Number: T 3 S; Range Number: R 3 E (circled).

Distance and direction from nearest town or city street address of well if located within city?

313 W. College Str., Washington, Kansas

Table with 2 columns: WATER WELL OWNER: Twin State Energy LLC; RR#, St. Address, Box #: P.O. Box 626; City, State, ZIP Code: Beatrice, Nebraska 68310; Board of Agriculture, Division of Water Resources; Application Number:

LOCATE WELL'S LOCATION WITH AN "X" IN SECTION BOX:

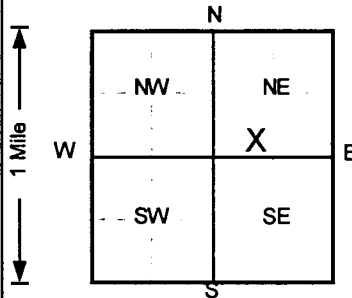


Table with 2 columns: DEPTH OF COMPLETED WELL: 28 ft; ELEVATION: 1333.92; WELL'S STATIC WATER LEVEL: 20.55 ft below land surface measured on 2/5/98; Pump test data: Well water was NA ft after NA hours pumping; Est. Yield: NA gpm; Bore Hole Diameter: 8 in. to 28 ft; WELL WATER TO BE USED AS: 10 Monitoring well; Was a chemical/bacteriological sample submitted: No; Water Well Disinfected? No.

Table with 2 columns: TYPE OF BLANK CASING USED: 2 PVC; 5 Wrought iron; 8 Concrete tile; CASING JOINTS: Threaded; 1 Steel; 3 RMP (SR); 6 Asbestos-Cement; 9 Other (specify below); 7 Fiberglass; Threaded.

Blank casing diameter: 2 in. to 18 ft, Dia. 18 in. to 18 ft, Dia. 18 in. to 18 ft; Casing height above land surface: -3.36 in., weight: Sch 40 lbs./ft. Wall thickness or gauge No.:

Table with 2 columns: TYPE OF SCREEN OR PERFORATION MATERIAL: 7 PVC; 10 Asbestos-cement; 1 Steel; 3 Stainless steel; 5 Fiberglass; 8 RMP (SR); 11 Other (specify); 2 Brass; 4 Galvanized steel; 6 Concrete tile; 9 ABS; 12 None used (open hole).

Table with 2 columns: SCREEN OR PERFORATION OPENINGS ARE: 3 Mill slot; 5 Gauzed wrapped; 8 Saw cut; 11 None (open hole); 1 Continuous slot; 6 Wire wrapped; 9 Drilled holes; 2 Louvered shutter; 4 Key punched; 7 Torch cut; 10 Other (specify).

SCREEN-PERFORATED INTERVALS: From 18 ft to 28 ft, From ft to ft, From ft to ft; GRAVEL PACK INTERVALS: From 16 ft to 28 ft, From ft to ft, From ft to ft.

Table with 2 columns: GROUT MATERIAL: 2 Cement grout; 3 Bentonite; 4 Other; Grout Intervals: From 0 ft to 14 ft, From 14 ft to 16 ft, From ft to ft.

Table with 2 columns: What is the nearest source of possible contamination: 16 Other (specify below) AST Tanks; 1 Septic tank; 4 Lateral lines; 7 Pit privy; 10 Livestock pens; 14 Abandoned water well; 2 Sewer lines; 5 Cess pool; 8 Sewage lagoon; 11 Fuel storage; 15 Oil well/Gas well; 3 Watertight sewer lines; 6 Seepage pit; 9 Feedyard; 12 Fertilizer storage; 13 Insecticide storage.

Table with 4 columns: FROM, TO, LITHOLOGIC LOG, PLUGGING INTERVALS. Rows: 0-2 Clay, Dark Brown; 2-8 Clay, Brown; 8-17 Clay, Red Brown; 17-28 Clay, Orange Brown; MW13, Tag # 00189101, Flushmount; Project Name: Farmers Oil Company; GeoCore # 556, KDHE # A5 101 40126.

CONTRACTOR'S OR LANDOWNER'S CERTIFICATION: This water well was (1) constructed, (2) reconstructed, or (3) plugged under my jurisdiction and was completed on (mo/day/year) 1/22/98 and this record is true to the best of my knowledge and belief. Kansas Water Well Contractor's License No. 527. This Water Well Record was completed on (mo/day/yr) 2/10/98 under the business name of GeoCore Services, Inc. by (signature) Dale Kohl.

INSTRUCTIONS: Use typewriter or ball point pen. PLEASE PRESS FIRMLY and PRINT clearly. Please fill in blanks, underline or circle the correct answers. Send top three copies to Kansas Department of Health and Environment, Bureau of Water, Topeka, Kansas 66620-0001. Telephone: 913-296-5545. Send one to WATER WELL OWNER and retain one for your records.