


1 LOCATION OF WATER WELL:
County: Washington
Fraction: NE 1/4 NW 1/4 SE 1/4
Section Number: 2
Township Number: T 3 S
Range Number: R 3 E/W

Distance and direction from nearest town or city street address of well if located within city?
313 W. College Str., Washington, Kansas

2 WATER WELL OWNER: Twin State Energy LLC
RP#, St. Address, Box#: P.O. Box 626
City, State, ZIP Code: Beatrice, Nebraska 68310
Board of Agriculture, Division of Water Resources
Application Number:

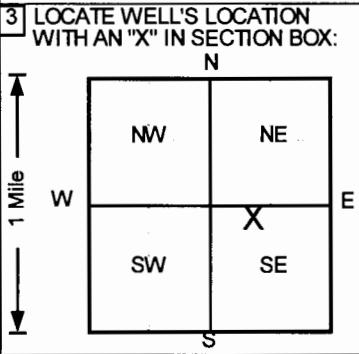

4 DEPTH OF COMPLETED WELL: 28 ft
ELEVATION: 1333.87
WELL'S STATIC WATER LEVEL: 19.13 ft below land surface measured on mo/day/yr: 2/5/98
Pump test data: Well water was NA ft after ... hours pumping ... gpm
Est. Yield: NA gpm
WELL WATER TO BE USED AS: 10 Monitoring well
Was a chemical/bacteriological sample submitted to Department? Yes/No
Water Well Disinfected? Yes/No

5 TYPE OF BLANK CASING USED: 1 Steel, 2 PVC, 3 RMP (SR), 4 ABS, 5 Wrought iron, 6 Asbestos-Cement, 7 Fiberglass, 8 Concrete tile, 9 Other (specify below)
Blank casing diameter: 2 in. to 18 ft, Dia. in. to ft, Dia. in. to ft
Casing height above land surface: -4.32 in., weight: Sch 40 lbs./ft. Wall thickness or gauge No.
TYPE OF SCREEN OR PERFORATION MATERIAL: 1 Steel, 2 Brass, 3 Mill slot, 4 Key punched, 5 Fiberglass, 6 Concrete tile, 7 PVC, 8 RMP (SR), 9 ABS, 10 Asbestos-cement, 11 Other (specify), 12 None used (open hole)
SCREEN OR PERFORATION OPENINGS ARE: 1 Continuous slot, 2 Louvered shutter, 3 Mill slot, 4 Key punched, 5 Gauzed wrapped, 6 Wire wrapped, 7 Torch cut, 8 Saw cut, 9 Drilled holes, 10 Other (specify), 11 None (open hole)
SCREEN-PERFORATED INTERVALS: From 18 ft to 28 ft, From ... ft to ... ft
GRAVEL PACK INTERVALS: From 16 ft to 28 ft, From ... ft to ... ft

6 GROUT MATERIAL: 1 Neat cement, 2 Cement grout, 3 Bentonite, 4 Other
Grout intervals: From 0 ft to 14 ft, From 14 ft to 16 ft, From ... ft to ... ft
What is the nearest source of possible contamination: 1 Septic tank, 2 Sewer lines, 3 Watertight sewer lines, 4 Lateral lines, 5 Cess pool, 6 Seepage pit, 7 Pit privy, 8 Sewage lagoon, 9 Feedyard, 10 Livestock pens, 11 Fuel storage, 12 Fertilizer storage, 13 Insecticide storage, 14 Abandoned water well, 15 Oil well/Gas well, 16 Other (specify below): AST Tanks
Direction from well? West
How many feet? 295

Table with columns FROM, TO, LITHOLOGIC LOG, FROM, TO, PLUGGING INTERVALS. Rows include lithology from 0-3 (Clay, Dark Brown), 3-10 (Clay, Brown), 10-17 (Clay, Red Brown), 17-28 (Clay, Orange-Brown). Includes MW8, Tag # 00263030, Flushmount and Project Name: Farmers Oil Company.

7 CONTRACTOR'S OR LANDOWNER'S CERTIFICATION: This water well was (1) constructed, (2) reconstructed, or (3) plugged under my jurisdiction and was completed on (mo/day/year) 1/20/98 and this record is true to the best of my knowledge and belief.
Kansas Water Well Contractor's License No. 527. This Water Well Record was completed on (mo/day/yr) 2/10/98 under the business name of GeoCore Services, Inc. by (signature)

OFFICE USE ONLY

T

R

EW

SEC.

1/4

1/4

1/4