

3

USE TYPEWRITER OR BALL POINT PEN—PRESS FIRMLY, PRINT CLEARLY.

NW SE SE  
WATER WELL RECORD  
KSA 82a-1201-1215


T R EW sec 1/4 1/4 1/4 No.

Kansas State Dept. Of Health  
(Water Well Contractors)  
Forbes-Bldg. 740  
Topeka, Kansas 66620

CW 1/2

1 Location of well: County WASHINGTON Township name WASHINGTON Fraction SE 1/4 Section number 1 Town number T3 S Range number R3 E

Distance and direction from nearest town or city: 1 East of Washington  
Street address of well location if in city: Washington  
3 Owner of well: BOB ROLLMAN  
Address: WASHINGTON KANSAS

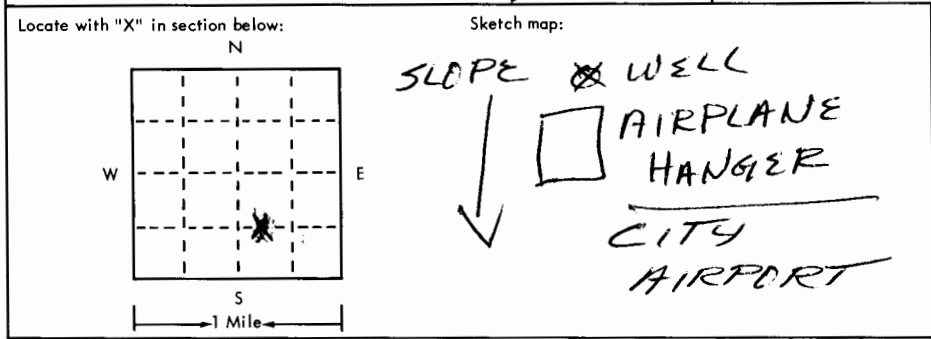

4 Well depth: 40 ft. Date of completion 10/29/75  
Well diameter 8 in.

5  Cable tool  Rotary  Driven  Dug  
 Hollow rod  Jetted  Bored  Reverse rotary

6 Use:  Domestic  Public supply  Industry  
 Irrigation  Air conditioning  Commercial  
 Test well

7 Casing: Material PVC Height above/below  
Threaded  Welded  Surface 72 in.  
Diam. 5 in. to 40 ft. depth/Drive shoe?  Yes  No  
— in. to — ft. depth

2	Type and color of material	From	To
	TOPSOIL	0	3
	BROWN CLAY	3	14
	SANDY CLAY	14	24
	SAND	24	27
	GRAVEL	27	32
	ROCK	32	33
	GRAY CLAY	33	37
	HARD ROCK	37	39
	SHALE STOP	40	
	(use a second sheet if needed)		

8 Screen: Manufacturer CERTAINTEED  
Type PVC Dia. 5"  
Slot/gauze 1/16" Length 20'  
Set between 20 ft. and 40 ft.  
Fittings: Gravel pack  Yes  No Size range of material 3/4"

9 Static water level: 12 ft. below land surface Date 10/29/75

10 Pumping level below land surfaces:  
— ft. after 1 hr. pumping — g.p.m.  
— ft. after 24 hr. pumping — g.p.m.  
Estimated maximum yield 50 g.p.m.

11 Water sample submitted:  
 Yes  No Date —

12 Well head completion:  
 Pitless adapter  Inches above grade

13 Well grouted?  Yes  No  
 Neat cement  Bentonite  —  
Depth: From 0 ft. to 10 ft.

14 Nearest source of possible contamination:  
ft. — Direction NW Type —  
Well disinfected upon completion?  Yes  No

15 Pump:  Not installed  
Manufacturer's name —  
Model number — HP — Volts —  
Length of drop pipe — ft. capacity — g.m.p.  
Type:  
 Submersible  Turbine  
 Jet  Reciprocating  
 Centrifugal  Other

16 Remarks: elevation 1280

Topography:  
 Hill  
 Slope  
 Upland  
 Valley

17 Water well contractor's certification:  
This well was drilled under my jurisdiction and this report is true to the best of my knowledge and belief.  
Geo Cox + Sons Inc 258  
Business name License No.  
Address WASHINGTON, KANSAS  
Signed Wayne Cox Date 11/29/75  
Authorized representative

3  
3E  
1  
CW 1/2  
SE