


1 LOCATION OF WATER WELL: County: Washington Fraction: NW 1/4 NW 1/4 NW 1/4 Section Number: 12 Township Number: T 3 S Range Number: R 3 (E)W

Distance and direction from nearest town or city street address of well if located within city? Kier's Short Stop, 220 E 7th, Washinton, Ks. MW#8

2 WATER WELL OWNER: George Leiszler - Leiszler Oil RR#, St. Address, Box #: 635 W Crawford City, State, ZIP Code: Clay Center, Ks. 67432 Board of Agriculture, Division of Water Resources Application Number:

3 LOCATE WELL'S LOCATION WITH AN "X" IN SECTION BOX:

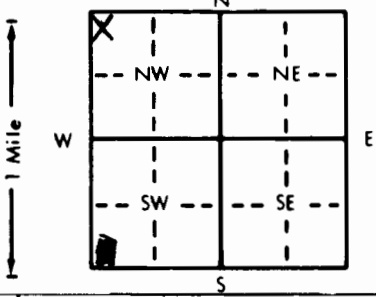

4 DEPTH OF COMPLETED WELL: 40 ft. ELEVATION: ... Depth(s) Groundwater Encountered: 1. 31 ft. 2. ... ft. 3. ... ft. WELL'S STATIC WATER LEVEL: 30.34 ft. below land surface measured on mo/day/yr: 5-23-91 Pump test data: Well water was ... ft. after ... hours pumping ... gpm Est. Yield ... gpm: Well water was ... ft. after ... hours pumping ... gpm Bore Hole Diameter: 7.5/8 in. to 40 ft., and ... in. to ... ft. WELL WATER TO BE USED AS: 5 Public water supply 8 Air conditioning 11 Injection well 1 Domestic 3 Feedlot 6 Oil field water supply 9 Dewatering 12 Other (Specify below) 2 Irrigation 4 Industrial 7 Lawn and garden only 10 Monitoring well Was a chemical/bacteriological sample submitted to Department? Yes ... No ... If yes, mo/day/yr sample was submitted Water Well Disinfected? Yes ... No ...

5 TYPE OF BLANK CASING USED: 1 Steel 3 RMP (SR) 5 Wrought iron 8 Concrete tile CASING JOINTS: Glued ... Clamped ... 2 PVC 4 ABS 6 Asbestos-Cement 9 Other (specify below) Welded ... Threaded ...

Blank casing diameter: 2 in. to 20 ft., Dia ... in. to ... ft., Dia ... in. to ... ft. Casing height above land surface: 0 in., weight ... lbs./ft. Wall thickness or gauge No. Schedule 40 TYPE OF SCREEN OR PERFORATION MATERIAL: 1 Steel 3 Stainless steel 5 Fiberglass 8 RMP (SR) 10 Asbestos-cement 2 Brass 4 Galvanized steel 6 Concrete tile 9 ABS 11 Other (specify) 12 None used (open hole)

SCREEN OR PERFORATION OPENINGS ARE: 1 Continuous slot 3 Mill slot 5 Gauzed wrapped 8 Saw cut 11 None (open hole) 2 Louvered shutter 4 Key punched 6 Wire wrapped 9 Drilled holes 10 Other (specify) SCREEN-PERFORATED INTERVALS: From 20 ft. to 40 ft., From ... ft. to ... ft. GRAVEL PACK INTERVALS: From 18 ft. to 40 ft., From ... ft. to ... ft.

6 GROUT MATERIAL: 1 Neat cement 2 Cement grout 3 Bentonite 4 Other Grout Intervals: From 0 ft. to 3 (cement) ft., From 3 ft. to 18 (bent) ft., From ... ft. to ... ft. What is the nearest source of possible contamination: 1 Septic tank 4 Lateral lines 7 Pit privy 11 Fuel storage 14 Abandoned water well 2 Sewer lines 5 Cess pool 8 Sewage lagoon 12 Fertilizer storage 15 Oil well/Gas well 3 Watertight sewer lines 6 Seepage pit 9 Feedyard 13 Insecticide storage 16 Other (specify below) Direction from well? N How many feet? 200

FROM	TO	LITHOLOGIC LOG	FROM	TO	PLUGGING INTERVALS
0	16	Clay, silty, brown			
16	20	Silt, sandy, reddish brown			
20	26	Sand, very fine, silty, reddish			
26	40	Sand, fine to coarse, reddish brown			

7 CONTRACTOR'S OR LANDOWNER'S CERTIFICATION: This water well was 1) constructed, (2) reconstructed, or (3) plugged under my jurisdiction and was completed on (mo/day/year) 5-21-91 and this record is true to the best of my knowledge and belief. Kansas Water Well Contractor's License No. 527. This Water Well Record was completed on (mo/day/yr) 5-22-91 under the business name of GeoCore Services, Inc. by (signature) Dale G. Ford

OFFICE USE ONLY T R EW SEC 1/4 1/4 1/4