

USE TYPEWRITER OR BALL-POINT PEN. PRESS FIRMLY. PRINT CLEARLY.

WATER WELL RECORD  
KSA 82a-1201-1215


Kansas Department of Health and Environment-Division of Environment  
(Water well Contractors)  
Topeka, Kansas 66620

NE 1/4 NW 1/4

1. Location of well: County WASHINGTON Fraction NE 1/4 NW 1/4 Section number 17 Township number T 3 S R 3 Range number 3 EW

2. Distance and direction from nearest town or city: 3 WEST 1-5 Street address of well location if in city: SW WASHINGTON

3. Owner of well: BEKEMEYER ENTERPRISES  
R.R. or street: ROUTE #1  
City, state, zip code: WASHINGTON, KANS 66968

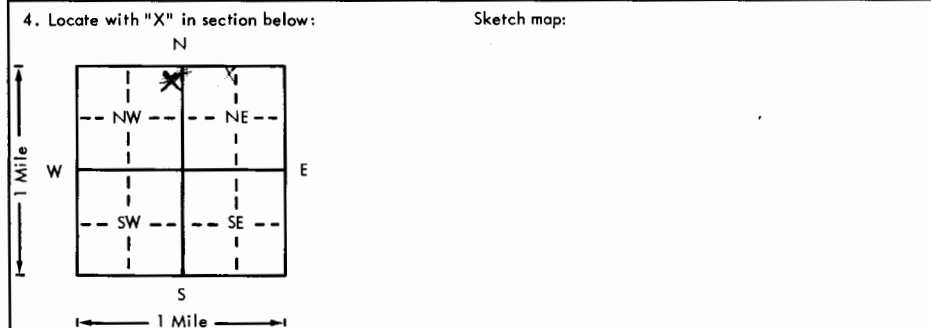

6. Bore hole dia. 8 in. Completion date: 2/17/77  
Well depth 90 ft.

7.  Cable tool  Rotary  Driven  Dug  
 Hollow rod  Jetted  Bored  Reverse rotary

8. Use:  Domestic  Public supply  Industry  
 Irrigation  Air conditioning  Stock  
 Lawn  Oil field water  Other

9. Casing: Material PUL Height Above or below  
Threaded  Welded  Surface 12 in.  
RMP  PVC  Weight 3 lbs./ft.  
Dia. 5 in. to 90 ft. depth Wall Thickness: inches or  
Dia. 5 in. to 90 ft. depth gage No. 1258

5. Type and color of material	From	To
<u>TOPSOIL</u>	<u>0</u>	<u>2</u>
<u>BROWN CLAY</u>	<u>2</u>	<u>17</u>
<u>SANDROCK</u>	<u>17</u>	<u>20</u>
<u>BROWN CLAY</u>	<u>20</u>	<u>25</u>
<u>GRAY CLAY</u>	<u>25</u>	<u>60</u>
<u>SANDROCK</u>	<u>60</u>	<u>90</u>
<u>BROWN CLAY</u>	<u>90</u>	
<u>STOP</u>	<u>90</u>	

10. Screen: Manufacturer's name PUMPCO  
Type PUL Dia. 5  
Slot gauze 1/16 Length 20'  
Set between 70 ft. and 90 ft.  
ft. and 90 ft.  
Gravel pack?  Yes Size range of material 1/8 X 1/4

11. Static water level: 50 ft. below land surface Date 2/17/77 mo./day/yr.

12. Pumping level below land surfaces:  
50 ft. after 1 hrs. pumping 50 g.p.m.  
50 ft. after 1 hrs. pumping 50 g.p.m.  
Estimated maximum yield 50 g.p.m.

13. Water sample submitted: X Yes X No Date \_\_\_\_\_ mo./day/yr.

14. Well head completion: 12 Pitless adapter 12 inches above grade

15. Well grouted?  Yes  
With:  Neat cement  Bentonite  Concrete  
Depth: From 0 ft. to 10 ft.

16. Nearest source of possible contamination: SEPTIC ft. 300 Direction SOUTH Type TANK  
Well disinfected upon completion?  Yes  No

17. Pump:  Not installed  
Manufacturer's name \_\_\_\_\_  
Model number \_\_\_\_\_ HP \_\_\_\_\_ Volts \_\_\_\_\_  
Length of drop pipe \_\_\_\_\_ ft. capacity \_\_\_\_\_ g.p.m.  
Type:  
 Submersible  Turbine  
 Jet  Reciprocating  
 Centrifugal  Other

18. Elevation: 1370'  
Topography:  Hill  Slope  Upland  Valley

19. Remarks:

20. Water well contractor's certification:  
This well was drilled under my jurisdiction and this report is true to the best of my knowledge and belief.  
BOB COX + SONS INC 258  
Business name License No. \_\_\_\_\_  
Address CLIFTON, KANS 66937  
Signed Raylyn Date 2/17/77  
Authorized representative

T 3 S R 3 W 17 NE 1/4 NW

Forward the white, blue and pink copies to the Department of Health and Environment

Form WWC-5