


1 LOCATION OF WATER WELL: Fraction NW 1/4 NW 1/4 NE 1/4 Section Number 12 Township Number T 3 S Range Number R 4E E/W
 County: WASHINGTON
 Distance and direction from nearest town or city street address of well if located within city?

5/8 mile east of Washington

2 WATER WELL OWNER: 3MK Pork L.L.C.
 RR#, St. Address, Box #: 2069 Prairie Road Board of Agriculture, Division of Water Resources
 City, State, ZIP Code: Washington, KS 66968-8620 Application Number:

3 LOCATE WELL'S LOCATION WITH AN "X" IN SECTION BOX:

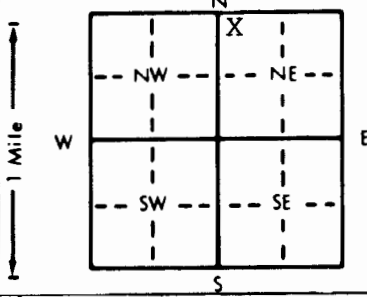

4 DEPTH OF COMPLETED WELL... 58' ft. ELEVATION:
 Depth(s) Groundwater Encountered 1. ft. 2. ft. 3. ft.
 WELL'S STATIC WATER LEVEL ... 17' ft. below land surface measured on mo/day/yr ... 4-23-96
 Pump test data: Well water was ft. after hours pumping gpm
 Est. Yield ... 12 ... gpm: Well water was ft. after hours pumping gpm
 Bore Hole Diameter ... 12" ... in. to ft., and in. to ft.
 WELL WATER TO BE USED AS: 5 Public water supply 8 Air conditioning 11 Injection well
 1 Domestic 3 Feedlot 6 Oil field water supply 9 Dewatering 12 Other (Specify below)
 2 Irrigation 4 Industrial 7 Lawn and garden only 10 Monitoring well
 Was a chemical/bacteriological sample submitted to Department? Yes.....No...X...; If yes, mo/day/yr sample was submitted
 Water Well Disinfected? Yes X No

5 TYPE OF BLANK CASING USED: 5 Wrought iron 8 Concrete tile CASING JOINTS: Glued .. X .. Clamped ..
 1 Steel 3 RMP (SR) 6 Asbestos-Cement 9 Other (specify below) Welded ..
 2 PVC 4 ABS 7 Fiberglass .. Threaded ..

Blank casing diameter 5" ... in. to 0-25 ... ft., Dia 5" ... in. to 35-57 ... ft., Dia in. to ft.
 Casing height above land surface 24" ... in., weight 2.82 ... lbs./ft. Wall thickness or gauge No. 258

TYPE OF SCREEN OR PERFORATION MATERIAL: 7 PVC 10 Asbestos-cement
 1 Steel 3 Stainless steel 5 Fiberglass 8 RMP (SR) 11 Other (specify) ..
 2 Brass 4 Galvanized steel 6 Concrete tile 9 ABS 12 None used (open hole)

SCREEN OR PERFORATION OPENINGS ARE: 5 Gauzed wrapped 8 Saw cut 11 None (open hole)
 1 Continuous slot 3 Mill slot 6 Wire wrapped 9 Drilled holes
 2 Louvered shutter 4 Key punched 7 Torch cut 10 Other (specify) ..

SCREEN-PERFORATED INTERVALS: From 25 ... ft. to 35 ... ft., From ft. to ft.
 From 57 ... ft. to 58 ... ft., From ft. to ft.
 GRAVEL PACK INTERVALS: From 23 ... ft. to 58 ... ft., From ft. to ft.
 From ft. to ft., From ft. to ft.

6 GROUT MATERIAL: 1 Neat cement 2 Cement grout 3 Bentonite 4 Other ..
 Grout Intervals: From 0 ... ft. to 23 ... ft., From ft. to ft., From ft. to ft.

What is the nearest source of possible contamination: 10 Livestock pens 14 Abandoned water well
~~1 Sewer lines~~ 4 Lateral lines 7 Pit privy 11 Fuel storage 15 Oil well/Gas well
 2 Sewer lines 5 Cess pool 8 Sewage lagoon 12 Fertilizer storage 16 Other (specify below)
 3 Watertight sewer lines 6 Seepage pit 9 Feedyard 13 Insecticide storage .. creek
 Direction from well? east How many feet? 60'

FROM	TO	LITHOLOGIC LOG	FROM	TO	PLUGGING INTERVALS
0)	6	Top Soil			
6	25	Clay-Br-Silty			
25	27	FS-CS-Med-Pea Brown			
27	28	Clay-Blue			
28	30	FS-CS-Med Pea Blue			
30	37	Limestone-Grey			
37	55	Shale-Grey			
55	58	Limestone-Grey			

7 CONTRACTOR'S OR LANDOWNER'S CERTIFICATION: This water well was (1) constructed, (2) reconstructed, or (3) plugged under my jurisdiction and was completed on (mo/day/year) 4-23-96 and this record is true to the best of my knowledge and belief. Kansas Water Well Contractor's License No. ... 182 This Water Well Record was completed on (mo/day/yr) ... 5-30-96 under the business name of STRADER DRILLING CO., INC. by (signature) *Dale Baker*

OFFICE USE ONLY
T
R
EW
SEC.