


1 LOCATION OF WATER WELL: Fraction NW 1/4 NW 1/4 SW 1/4 Section Number 8 Township Number T 3 S Range Number R 4 E
 County: WASHINGTON

Distance and direction from nearest town or city street address of well if located within city?
25'S - 60'E OF NW C - LANDFILL

2 WATER WELL OWNER: WASHINGTON COUNTY
 RR#, St. Address, Box #: 812 B. STREET
 City, State, ZIP Code: WASHINGTON KS 66968
 Board of Agriculture, Division of Water Resources
 Application Number:

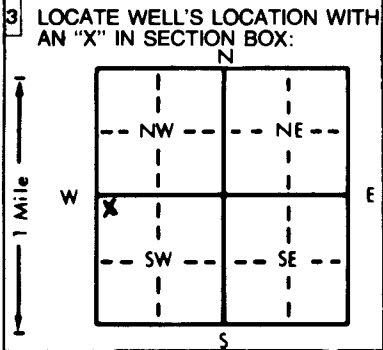

4 DEPTH OF COMPLETED WELL: 55 ft. ELEVATION:
 Depth(s) Groundwater Encountered 1. 41 ft. 2. --- ft. 3. --- ft.
 WELL'S STATIC WATER LEVEL 41.61 ft. below land surface measured on mo/day/yr 01-21-94
 Pump test data: Well water was --- ft. after --- hours pumping --- gpm
 Est. Yield --- gpm: Well water was --- ft. after --- hours pumping --- gpm
 Bore Hole Diameter: 7.75 in. to 55 ft., and --- in. to --- ft.
 WELL WATER TO BE USED AS:
 5 Public water supply 8 Air conditioning 11 Injection well
 1 Domestic 3 Feedlot 6 Oil field water supply 9 Dewatering 12 Other (Specify below)
 2 Irrigation 4 Industrial 7 Lawn and garden only 10 Monitoring well
 Was a chemical/bacteriological sample submitted to Department? Yes --- No X; If yes, mo/day/yr sample was submitted ---
 Water Well Disinfected? Yes --- No X

5 TYPE OF BLANK CASING USED:
 1 Steel 3 RMP (SR) 5 Wrought iron 8 Concrete tile CASING JOINTS: Glued --- Clamped ---
 2 PVC 4 ABS 6 Asbestos-Cement 9 Other (specify below) Welded ---
 7 Fiberglass Threaded X
 Blank casing diameter 4 in. to 29 ft., Dia --- in. to --- ft., Dia --- in. to --- ft.
 Casing height above land surface 24 in., weight SCH 40 lbs./ft. Wall thickness or gauge No. ---
 TYPE OF SCREEN OR PERFORATION MATERIAL:
 1 Steel 3 Stainless steel 5 Fiberglass 8 RMP (SR) 10 Asbestos-cement
 2 Brass 4 Galvanized steel 6 Concrete tile 9 ABS 12 None used (open hole)
 SCREEN OR PERFORATION OPENINGS ARE:
 1 Continuous slot 3 Mill slot 5 Gauzed wrapped 8 Saw cut 11 None (open hole)
 2 Louvered shutter 4 Key punched 6 Wire wrapped 9 Drilled holes
 7 Torch cut 10 Other (specify) ---
 SCREEN-PERFORATED INTERVALS: From 29 ft. to 49 ft., From --- ft. to --- ft.
 From --- ft. to --- ft., From --- ft. to --- ft.
 GRAVEL PACK INTERVALS: From 27 ft. to 55 ft., From --- ft. to --- ft.
 From --- ft. to --- ft., From --- ft. to --- ft.

6 GROUT MATERIAL: 1 Neat cement 2 Cement grout 3 Bentonite 4 Other ---
 Grout Intervals: From 64 ft. to 25 ft., From 25 ft. to 27 ft., From --- ft. to --- ft.
 What is the nearest source of possible contamination:
 1 Septic tank 4 Lateral lines 7 Pit privy 10 Livestock pens 14 Abandoned water well
 2 Sewer lines 5 Cess pool 8 Sewage lagoon 11 Fuel storage 15 Oil well/Gas well
 3 Watertight sewer lines 6 Seepage pit 9 Feedyard 12 Fertilizer storage 16 Other (specify below) LAND FILL
 13 Insecticide storage
 Direction from well? SE - WELL IS ON SITE How many feet? ---

FROM	TO	LITHOLOGIC LOG	FROM	TO	PLUGGING INTERVALS
<u>64</u>	<u>2</u>	<u>SOIL - ROCKS</u>			
<u>2</u>	<u>8</u>	<u>SILTY CLAY</u>			
<u>8</u>	<u>10</u>	<u>LIME STONE</u>			
<u>10</u>	<u>19</u>	<u>SILTY CLAY</u>			
<u>19</u>	<u>24</u>	<u>SHALE</u>			
<u>24</u>	<u>25</u>	<u>LIME STONE</u>			
<u>25</u>	<u>32</u>	<u>SHALE</u>			
<u>32</u>	<u>34</u>	<u>LIME STONE</u>			
<u>34</u>	<u>37</u>	<u>SHALE</u>			
<u>37</u>	<u>41</u>	<u>LIME STONE LAYERS - BROKEN</u>			
<u>41</u>	<u>45</u>	<u>SHALE</u>			
<u>45</u>	<u>51</u>	<u>SHALE - BLUE GREY</u>			
<u>51</u>	<u>55</u>	<u>LIME STONE - TAN</u>			
<u>TD</u>	<u>55</u>				

7 CONTRACTOR'S OR LANDOWNER'S CERTIFICATION: This water well was (1) constructed, (2) reconstructed, or (3) plugged under my jurisdiction and was completed on (mo/day/year) 01-03-94 and this record is true to the best of my knowledge and belief. Kansas Water Well Contractor's License No. 479 This Water Well Record was completed on (mo/day/yr) 02-04-94 under the business name of EBBERTS DRILLING by (signature) Gregory Eberts