USE TYPEWRITER OR BALL POINT PEN-PRESS FIRMLY, PRINT CLEARLY.

WATER WELL RECORD
KSA 82a-1201-1215

Kansas Department of Health and Environment-Division of Environment
(Water well Contractors)
Topeka, Kansas 66620

1. Location of well: County: Washington | Fraction: SE NE S.E (1/4 1/4 1/4) | Section number: 23 | Township number: T 3 South S | Range number: R 4 east E/W

2. Distance and direction from nearest town or city: on 15 Tiway South of Little Blue bridge 1 W. 4 north. 3 west. 3/4 South
Street address of well location if in city: West in Pasture

Owner of well: Frederick Mueller
R.R. or street:
City, state, zip code: Hanover Kans

4. Locate with "X" in section below:

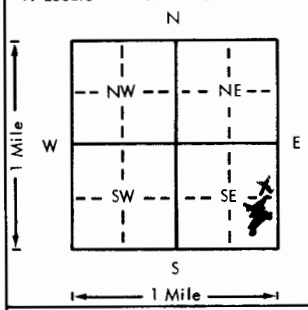

Sketch map:

6. Bore hole dia. 11 in. Completion date 8-18-77
Well depth 36 ft.

7. X Cable tool __ Rotary __ Driven __ Dug
__ Hollow rod __ Jetted __ Bored __ Reverse rotary

8. Use: __ Domestic __ Public supply __ Industry
__ Irrigation __ Air conditioning X Stock
__ Lawn __ Oil field water __ Other

9. Casing: Material Steel | Height: Above or below
Threaded X Welded __ | Surface 12
RMP __ PVC X | Weight 200 lb
Dia. 5 in. to 36 ft. depth | Wall Thickness: inches 2.67 W wall
Dia. 1 in. to 40 ft. | Gauge No. 22 lb to ft 4½ wall

5. Type and color of material

From	To
old well in Pasture	
Pulled Casing out &	
drilled well 20 ft deeper	
Shale Blue	36 56

(Use a second sheet if needed)

10. Screen: Monufacturer's name Pumper
Type PVC Dia. 5"
Slot/gauze .050 Length 20'
Set between 40 ft. and 56 ft.
ft. and ft.
Gravel pack? no Size range of material

11. Static water level: mo./day/yr.
19 ft. below land surface Date 8-18-77

12. Pumping level below land surfaces:
ft. ofter hrs. pumping g.p.m.
ft. ofter hrs. pumping g.p.m.
Estimated maximum yield 5 g.p.m.

13. Water sample submitted: mo./day/yr.
__ Yes X No Date

14. Well head completion: Windmill
__ Pitless adapter 12 Inches above grade

15. Well grouted? X
With: X Neat cement __ Bentonite __ Concrete
Depth: From 12 ft. to 40 ft.

16. Nearest source of possible contamination:
ft. 100 Direction West Type Ditch
Well disinfected upon completion? X Yes __ No

17. Pump: X Not installed old
Manufacturer's name
Model number Pump set back in Well Volts
Length of drop pipe Capacity g.p.m.
Type:
__ Submersible __ Turbine
__ Jet __ Reciprocating
__ Centrifugal __ Other

T 3 R 4 E/W Sec 23 1/4 1/4 1/4 SE NE SE

18. Elevation: 1290 ft
Topography:
__ Hill
X Slope
__ Upland
__ Valley

19. Remarks:

20. Water well contractor's certification:
This well was drilled under my jurisdiction and this report is true to the best of my knowledge and belief.
Business name Strader Drilling Co. License No. 23
Address Blue Rapids
Signed Harold Strader Date 8-18-
Authorized representative

Forward the white, blue and pink copies to the Department of Health and Environment

Form WWC-5

MI-1023