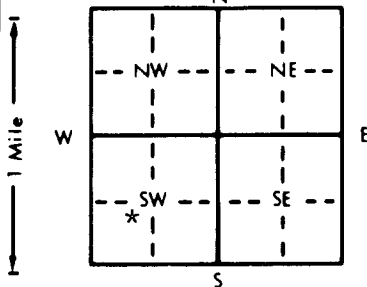


1 LOCATION OF WATER WELL: Fraction Section Number Township Number Range Number  
 County: Washington NE 1/4 SW 1/4 SW 1/4 20 T 3 S R 5 **EW**

Distance and direction from nearest town or city street address of well if located within city?  
1 1/2 West, 4 North of Barnes

2 WATER WELL OWNER: Micheal Rencin  
 RR#, St. Address, Box # : Rt. 1 Board of Agriculture, Division of Water Resources  
 City, State, ZIP Code : Barnes, KS. 66933 Application Number:

3 LOCATE WELL'S LOCATION WITH AN "X" IN SECTION BOX:  
  
 4 DEPTH OF COMPLETED WELL: 118 ft. ELEVATION:  
 Depth(s) Groundwater Encountered 1. .... ft. 2. .... ft. 3. .... ft.  
 WELL'S STATIC WATER LEVEL 50 ft. below land surface measured on mo/day/yr 2/3/97  
 Pump test data: Well water was .... ft. after .... hours pumping .... gpm  
 Est. Yield 30-40 gpm: Well water was .... ft. after .... hours pumping .... gpm  
 Bore Hole Diameter: 8 3/4 in. to 122 ft., and .... in. to .... ft.  
 WELL WATER TO BE USED AS:  
 5 Public water supply 8 Air conditioning 11 Injection well  
 1 Domestic 3 Feedlot 6 Oil field water supply 9 Dewatering 12 Other (Specify below)  
 2 Irrigation 4 Industrial 7 Lawn and garden only 10 Monitoring well Hog Building  
 Was a chemical/bacteriological sample submitted to Department? Yes.....No \*; If yes, mo/day/yr sample was sub-  
 mitted Water Well Disinfected? Yes \* No

5 TYPE OF BLANK CASING USED:  
 1 Steel 3 RMP (SR) 5 Wrought iron 8 Concrete tile CASING JOINTS: Glued \* Clamped  
 2 PVC 4 ABS 6 Asbestos-Cement 9 Other (specify below) Welded  
 7 Fiberglass Threaded  
 Blank casing diameter 5 in. to 58 ft., Dia. .... in. to .... ft., Dia. .... in. to .... ft.  
 Casing height above land surface 24 in., weight 200 lbs./ft. Wall thickness or gauge No.  
 TYPE OF SCREEN OR PERFORATION MATERIAL:  
 1 Steel 3 Stainless steel 5 Fiberglass 7 PVC 10 Asbestos-cement  
 2 Brass 4 Galvanized steel 6 Concrete tile 8 RMP (SR) 11 Other (specify)  
 9 ABS 12 None used (open hole)  
 SCREEN OR PERFORATION OPENINGS ARE:  
 5 Gauzed wrapped 8 Saw cut 11 None (open hole)  
 1 Continuous slot 3 Mill slot 6 Wire wrapped 9 Drilled holes  
 2 Louvered shutter 4 Key punched 7 Torch cut 10 Other (specify)  
 SCREEN-PERFORATED INTERVALS: From 58 ft. to 78 ft., From .... ft. to .... ft.  
 From 98 ft. to 118 ft., From .... ft. to .... ft.  
 GRAVEL PACK INTERVALS: From 40 ft. to 118 ft., From .... ft. to .... ft.  
 From .... ft. to .... ft., From .... ft. to .... ft.

6 GROUT MATERIAL: 1 Neat cement 2 Cement grout 3 Bentonite 4 Other  
 Grout intervals: From 5 ft. to 40 ft., From .... ft. to .... ft., From .... ft. to .... ft.  
 What is the nearest source of possible contamination:  
 1 Septic tank 4 Lateral lines 7 Pit privy 10 Livestock pens 14 Abandoned water well  
 2 Sewer lines 5 Cess pool 8 Sewage lagoon 11 Fuel storage 15 Oil well/Gas well  
 3 Watertight sewer lines 6 Seepage pit 9 Feedyard 12 Fertilizer storage 16 Other (specify below)  
 13 Insecticide storage  
 Direction from well? None present How many feet?

FROM	TO	LITHOLOGIC LOG	FROM	TO	PLUGGING INTERVALS
0	7	Brown Clay			
7	9	Red Shale			
9	16	Tan Shale			
16	27	Red Shale			
27	38	Tan Shale			
38	53	Limestone & Shale			
53	58	<del>Limestone</del> Gray Shale			
58	61	Limestone			
61	66	Gray Shale			
66	70	Yellow Shale			
70	71	Gray Shale			
71	111	Red Shale			
111	122	GRAY Shale & Gypsum			

7 CONTRACTOR'S OR LANDOWNER'S CERTIFICATION: This water well was (1) constructed, (2) reconstructed, or (3) plugged under my jurisdiction and was completed on (mo/day/year) 2/3/97 and this record is true to the best of my knowledge and belief. Kansas Water Well Contractor's License No. 518 This Water Well Record was completed on (mo/day/yr) 2/8/97 under the business name of Blue Valley Drilling by (signature) Evo [Signature]

INSTRUCTIONS: Use typewriter or ball point pen. PLEASE PRESS FIRMLY and PRINT clearly. Please fill in blanks, underline or circle the correct answers. Send top three copies to Kansas Department of Health and Environment, Bureau of Water, Topeka, Kansas 66620-0001. Telephone: 913-296-5545. Send one to WATER WELL OWNER and retain one for your records.

OFFICE USE ONLY  
T  
R  
EW  
SEC.