


1	LOCATION OF WATER WELL:	Fraction	Section Number	Township Number	Range Number
	County: <u>WASHINGTON</u>	<u>NW SW 1/4 SE 1/4</u>	<u>24</u>	<u>T-3-S</u>	<u>R-5-E E/W</u>

Distance and direction from nearest town or city street address of well if located within city?  
FROM BARNES KS - 4 MILES NORTH + 2 1/2 MILES EAST

2	WATER WELL OWNER: <u>DEROIN VOGLER TRUST</u> <u>1622 GOZAGA WADE</u> RR #, St. Address, Box #: City, State, ZIP Code : <u>FAIRBANK AK. 99709</u>	Board of Agriculture, Division of Water Resources Application Number:
---	---	--

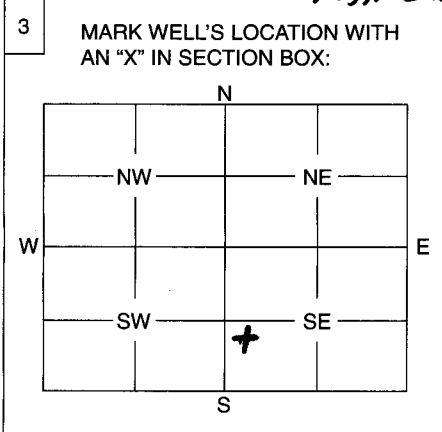

4	DEPTH OF WELL ..... <u>78</u> ..... ft. WELL'S STATIC WATER LEVEL <u>72</u> ..... ft. WELL WAS USED AS: <input checked="" type="checkbox"/> 1 Domestic <input type="checkbox"/> 2 Irrigation <input type="checkbox"/> 3 Feedlot <input type="checkbox"/> 4 Industrial <input type="checkbox"/> 5 Public Water Supply <input type="checkbox"/> 6 Oil Field Water Supply <input type="checkbox"/> 7 Domestic (Lawn & Garden) <input type="checkbox"/> 8 Air Conditioning <input type="checkbox"/> 9 Dewatering <input type="checkbox"/> 10 Monitoring Well <input type="checkbox"/> 11 Injection Well <input type="checkbox"/> 12 Other .....
Was a chemical / bacteriological sample submitted to Department? Yes ..... No .....	
If yes, mo/day/yr sample was submitted .....	
Water Well Disinfected: Yes <input checked="" type="checkbox"/> No .....	

5	TYPE OF BLANK CASING USED: <input checked="" type="checkbox"/> 1 Steel <input type="checkbox"/> 2 PVC <input type="checkbox"/> 3 RMP (SR) <input type="checkbox"/> 4 ABS <input type="checkbox"/> 5 Wrought <input type="checkbox"/> 6 Asbestos-Cement <input type="checkbox"/> 7 Fiberglass <input type="checkbox"/> 8 Concrete Tile <input type="checkbox"/> 9 Other (Specify below) .....
Blank casing diameter <u>6</u> in. Was casing pulled? Yes <input checked="" type="checkbox"/> No .....	
Casing height <u>7 FT</u> or below land surface If yes, how much <u>68 1/2 FT</u>	

6	GROUT PLUG MATERIAL: <input type="checkbox"/> 1 Neat cement <input type="checkbox"/> 2 Cement grout <input checked="" type="checkbox"/> 3 Bentonite <input type="checkbox"/> 4 Other .....
Grout Plug Intervals: From <u>78</u> ft. to <u>7</u> ft., From ..... ft. to ..... ft., From ..... to ..... ft.	
What is the nearest source of possible contamination: <input type="checkbox"/> 1 Septic tank <input type="checkbox"/> 6 Seepage pit <input type="checkbox"/> 11 Fuel storage <input type="checkbox"/> 16 Other (specify below) <input type="checkbox"/> 2 Sewer lines <input type="checkbox"/> 7 Pit privy <input type="checkbox"/> 12 Fertilizer storage <input type="checkbox"/> 3 Watertight sewer lines <input type="checkbox"/> 8 Sewage lagoon <input type="checkbox"/> 13 Insecticide storage <input type="checkbox"/> 4 Lateral lines <input type="checkbox"/> 9 Feedyard <input type="checkbox"/> 14 Abandoned water well <input type="checkbox"/> 5 Cess pool <input type="checkbox"/> 10 Livestock pens <input type="checkbox"/> 15 Oil well/Gas well	
Direction from well? ..... How many feet? .....	

FROM	TO	PLUGGING MATERIALS
<u>78</u>	<u>7</u>	<u>BENTONITE (27 SACKS) 25 CU. FT.</u>
<u>7</u>	<u>3</u>	<u>LIMESTONE + SHALE</u>
<u>3</u>	<u>0</u>	<u>TOP SOIL</u>

7	CONTRACTOR'S OF LANDOWNER'S CERTIFICATION: This water well was plugged under my jurisdiction and was completed on (mo/day/year) <u>7-9-03</u> and this record is true to the best of my knowledge and belief. Kansas Water Well Contractor's License No. <u>647</u> This Water Well Record was completed on (mo/day/year) <u>7-10-03</u> under the business name of <u>MEL'S PUMP &amp; PLUMBING</u> by (signature) <u>Melvin M Anderson</u>
---	---

INSTRUCTIONS: Use typewriter or ball point pen. Please press firmly and print clearly. Please fill in blanks, underline or circle the correct answers. Send top three copies to Kansas Department of Health and Environment, Bureau of Water, Geology Section, 1000 SW Jackson St., Ste. 420, Topeka, Kansas 66612-1367. Telephone: 785/296-5522. Send one to Water Well Owner and retain one for your records.