

1 LOCATION OF WATER WELL: Fraction NW ¼ SE ¼ SE ¼ Section Number 18 Township Number T 3 S Range Number R 5 (E)W  
 County: **Washington**


Distance and direction from nearest town or city street address of well if located within city?

**1½ West & 5 North of Barnes, KS**

2 WATER WELL OWNER: **Beaver Creek Pkk**  
 RR#, St. Address, Box # : **2547 15th Road** Board of Agriculture, Division of Water Resources  
 City, State, ZIP Code : **Barnes, KS 66933** Application Number:

3 LOCATE WELL'S LOCATION WITH 4 DEPTH OF COMPLETED WELL ..... **1.10** ..... ft. ELEVATION: .....

AN "X" IN SECTION BOX:

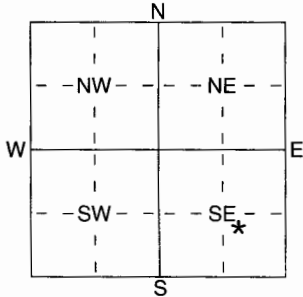

Depth(s) Groundwater Encountered 1 ..... ft. 2 ..... ft. 3 ..... ft.  
 WELL'S STATIC WATER LEVEL ..... **56** ..... ft. below land surface measured on mo/day/yr ..... **1/20/05**  
 Pump test data: Well water was ..... ft. after ..... hours pumping ..... gpm  
 Est. Yield **7.5** ..... gpm: Well water was ..... ft. after ..... hours pumping ..... gpm  
 WELL WATER TO BE USED AS: 5 Public water supply 8 Air conditioning 11 Injection well  
 1 Domestic 3 Feedlot 6 Oil field water supply 9 Dewatering 12 Other (Specify below)  
 2 Irrigation 4 Industrial 7 Domestic (lawn & garden) 10 Monitoring well **Hog Building**

Was a chemical/bacteriological sample submitted to Department? Yes ..... No **\***; If yes, mo/day/yr sample was submitted  
 Water Well Disinfected? Yes **\*** No

5 TYPE OF BLANK CASING USED: 5 Wrought iron 8 Concrete tile CASING JOINTS: Glued **\*** Clamped .....  
 1 Steel 3 RMP (SR) 6 Asbestos-Cement 9 Other (specify below) Welded .....  
 2 PVC 4 ABS 7 Fiberglass ..... Threaded .....

Blank casing diameter ..... **5** ..... in. to ..... **90** ..... ft., Dia ..... in. to ..... ft., Dia ..... in. to ..... ft.  
 Casing height above land surface ..... **1.8** ..... in., weight ..... **200** ..... lbs./ft. Wall thickness or gauge No. **.265**

TYPE OF SCREEN OR PERFORATION MATERIAL: 7 PVC 10 Asbestos-Cement  
 1 Steel 3 Stainless Steel 5 Fiberglass 8 RMP (SR) 11 Other (Specify) .....  
 2 Brass 4 Galvanized Steel 6 Concrete tile 9 ABS 12 None used (open hole)

SCREEN OR PERFORATION OPENINGS ARE: 5 Gauzed wrapped 8 Saw cut 11 None (open hole)  
 1 Continuous slot 3 Mill slot 6 Wire wrapped 9 Drilled holes  
 2 Louvered shutter 4 Key punched 7 Torch cut 10 Other (specify) ..... ft.

SCREEN-PERFORATED INTERVALS: From ..... **90** ..... ft. to ..... **110** ..... ft., From ..... ft. to ..... ft.  
 GRAVEL PACK INTERVALS: From ..... **30** ..... ft. to ..... **110** ..... ft., From ..... ft. to ..... ft.  
 From ..... ft. to ..... ft., From ..... ft. to ..... ft.

6 GROUT MATERIAL: 1 Neat cement 2 Cement grout 3 Bentonite 4 Other .....  
 Grout Intervals: From ..... **5** ..... ft. to ..... **30** ..... ft., From ..... ft. to ..... ft., From ..... ft. to ..... ft.

What is the nearest source of possible contamination:  
 1 Septic tank 4 Lateral lines 7 Pit privy 10 Livestock pens 14 Abandoned water well  
 2 Sewer lines 5 Cess pool 8 Sewage lagoon 11 Fuel storage 15 Oil well/Gas well  
 3 Watertight sewer lines 6 Seepage pit 9 Feedyard 12 Fertilizer storage 16 Other (specify below)  
 13 Insecticide storage

Direction from well? **None Present**

FROM	TO	LITHOLOGIC LOG	FROM	TO	PLUGGING INTERVALS
0	11	Brown Clay			
11	37	Sand (Fine- Med.)			
37	42	Yellow Clay			
42	95	Red Shale			
95	103	Limestone			
103	110	Gray Shale & Limestone			

7 CONTRACTOR'S OR LANDOWNER'S CERTIFICATION: This water well was (1) constructed, (2) reconstructed, or (3) plugged under my jurisdiction and was completed on (mo/day/year) ..... and this record is true to the best of my knowledge and belief. Kansas Water Well Contractor's Licence No ..... **518** ..... This Water Well Record was completed on (mo/day/yr) ..... under the business name of **Blue Valley Drilling** by (signature) *Tim Hall*