


1 LOCATION OF WATER WELL: Fraction ~~NE~~ ^{SE} ~~SE~~ ^{NE} Section Number 12 Township Number T 3 S Range Number R 6 ^{EN}

Distance and direction from nearest town or city street address of well if located within city?
 2 mile West and 2 1/4 south of Marysville

2 WATER WELL OWNER: Leslie Ham
 RR#, St. Address, Box #: Emporia Kans 66801
 City, State, ZIP Code: Board of Agriculture, Division of Water Resources
 Application Number:

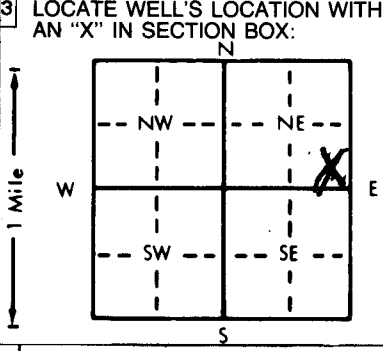

4 DEPTH OF COMPLETED WELL: 62 ft. ELEVATION:
 Depth(s) Groundwater Encountered 1. 31.30 ft. 2. .ft. 3. .ft.
 WELL'S STATIC WATER LEVEL 31.30 ft. below land surface measured on mo/day/yr 7-9-86
 Pump test data: Well water was .ft. after . hours pumping . gpm
 Est. Yield 9 gpm Well water was .ft. after . hours pumping . gpm
 Bore Hole Diameter 10 in. to 16 ft., and 6 1/2 in. to 62 ft.
 WELL WATER TO BE USED AS:
 1 Domestic (circled) 3 Feedlot 6 Oil field water supply 9 Dewatering 12 Other (Specify below)
 2 Irrigation 4 Industrial 7 Lawn and garden only 10 Observation well
 Was a chemical/bacteriological sample submitted to Department? Yes.....No...X.....; If yes, mo/day/yr sample was submitted
 Water Well Disinfected? Yes X No

5 TYPE OF BLANK CASING USED:
 1 Steel (circled) 3 RMP (SR) 6 Asbestos-Cement 9 Other (specify below) Welded
 2 PVC (circled) 4 ABS 7 Fiberglass Threaded
 Blank casing diameter 5 in. to 42 ft., Dia 5 in. to 62 ft., Dia . in. to . ft.
 Casing height above land surface 12 in., weight . lbs./ft. Wall thickness or gauge No.
 TYPE OF SCREEN OR PERFORATION MATERIAL:
 1 Steel 3 Stainless steel 5 Fiberglass 7 PVC (circled) 10 Asbestos-cement
 2 Brass 4 Galvanized steel 6 Concrete tile 9 ABS 11 Other (specify)
 SCREEN OR PERFORATION OPENINGS ARE:
 1 Continuous slot 3 Mill slot 5 Gauzed wrapped 8 Saw cut (circled) 11 None (open hole)
 2 Louvered shutter 4 Key punched 6 Wire wrapped 9 Drilled holes
 7 Torch cut 10 Other (specify)
 SCREEN-PERFORATED INTERVALS: From 62 ft. to 42 ft., From . ft. to . ft.
 GRAVEL PACK INTERVALS: From 62 ft. to 16 ft., From . ft. to . ft.

6 GROUT MATERIAL: 1 Neat cement Cement grout (circled) 3 Bentonite 4 Other
 Grout intervals: From . ft. to . ft. From . ft. to . ft. From . ft. to . ft.
 What is the nearest source of possible contamination:
 1 Septic tank (circled) 4 Lateral lines 7 Pit privy 10 Livestock pens 14 Abandoned water well
 2 Sewer lines 5 Cess pool 8 Sewage lagoon 11 Fuel storage 15 Oil well/Gas well
 3 Watertight sewer lines 6 Seepage pit 9 Feedyard 12 Fertilizer storage 16 Other (specify below)
 13 Insecticide storage
 Direction from well? South How many feet? 100

FROM	TO	LITHOLOGIC LOG	FROM	TO	LITHOLOGIC LOG
0	2	top soil			
2	7	clay, yellow			
7	23	Rock, limestone, yellow			
23	35	clay Red			
35	52	Rock, Limestone + Porrous, water at 50'			
52	62	shale, blue			

7 CONTRACTOR'S OR LANDOWNER'S CERTIFICATION: This water well was (1) constructed, (2) reconstructed, or (3) plugged under my jurisdiction and was completed on (mo/day/year) July - 9 - 86 and this record is true to the best of my knowledge and belief. Kansas Water Well Contractor's License No. 237 This Water Well Record was completed on (mo/day/yr) July 9, 1986 under the business name of Strader Drilling Co by (signature) Harold Strader

INSTRUCTIONS: Use typewriter or ball point pen, PLEASE PRESS FIRMLY and PRINT clearly. Please fill in blanks, underline or circle the correct answers. Send top three copies to Kansas Department of Health and Environment, Division of Environmental Geology Section, Topeka, KS 66620. Send one to WATER WELL OWNER and retain one for your records.