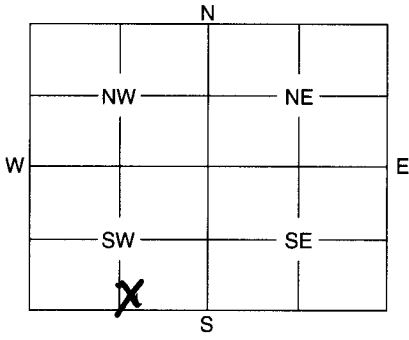


1 LOCATION OF WATER WELL: Fraction Section Number Township Number Range Number
 County: MARSHALL SW 1/4 SE 1/4 SW 1/4 13 3 6 EAN

Distance and direction from nearest town or city street address of well if located within city?

2 WATER WELL OWNER: RIK AND CAROL WRIGHT
 RR #, St. Address, Box #: 634 OSAGE RD Board of Agriculture, Division of Water Resources
 City, State, ZIP Code: MARYSVILLE, KS 66508 Application Number: _____

3 MARK WELL'S LOCATION WITH AN "X" IN SECTION BOX:

 4 DEPTH OF WELL 93 ft.
 WELL'S STATIC WATER LEVEL 38 ft.
 WELL WAS USED AS:
 1 Domestic 5 Public Water Supply 9 Dewatering
 2 Irrigation 6 Oil Field Water Supply 10 Monitoring Well
 3 Feedlot 7 Domestic (Lawn & Garden) 11 Injection Well
 4 Industrial 8 Air Conditioning 12 Other _____
 Was a chemical / bacteriological sample submitted to Department? Yes _____ No
 If yes, mo/day/yr sample was submitted _____
 Water Well Disinfected: Yes No _____

5 TYPE OF BLANK CASING USED:
STEEL PIPE
 1 Steel 3 RMP (SR) 5 Wrought 7 Fiberglass 9 Other (Specify below)
 2 PVC 4 ABS 6 Asbestos-Cement 8 Concrete Tile
 Blank casing diameter 5 in. Was casing pulled? Yes No _____ If yes, how much 5 feet
 Casing height above or below and surface 60 in.

6 GROUT PLUG MATERIAL: 1 Neat cement 2 Cement grout 3 Bentonite 4 Other _____
 Grout Plug Intervals: From 5 ft. to 93 ft., From _____ ft. to _____ ft., From _____ to _____ ft.
 What is the nearest source of possible contamination:
 1 Septic tank 6 Seepage pit 11 Fuel storage 16 Other (specify below) HOLE
 2 Sewer lines 7 Pit privy 12 Fertilizer storage
 3 Watertight sewer lines 8 Sewage lagoon 13 Insecticide storage
 4 Lateral lines 9 Feedyard 14 Abandoned water well
 5 Cess pool 10 Livestock pens 15 Oil well/Gas well
 Direction from well? WEST How many feet? 50

FROM	TO	PLUGGING MATERIALS
0	5	SOIL (0.7 ft ³)
5	93	BENTONITE (14 Bags)

7 CONTRACTOR'S OF LANDOWNER'S CERTIFICATION: This water well was plugged under my jurisdiction and was completed on (mo/day/year) 12-18-2010 and this record is true to the best of my knowledge and belief. Kansas Water Well Contractor's License No. 760 This Water Well Record was completed on (mo/day/year) 4-1-2011 under the business name of ASSOCIATION OF DRILLING FIRMS by (signature) [Signature]

INSTRUCTIONS: Use typewriter or ball point pen. Please press firmly and print clearly. Please fill in blanks, underline or circle the correct answers. Send top three copies to Kansas Department of Health and Environment, Bureau of Water, Geology Section, 1000 SW Jackson St., Ste. 420, Topeka, Kansas 66612-1367. Telephone: 785/296-5522. Send one to Water Well Owner and retain one for your records.