

County: Marshall Fraction: SW SE SW SE Sec. 4 T. 3 S R. 6 E

CORRECTION(S) to WATER WELL COMPLETION RECORD Form WWC-5 (to rectify lacking or incorrect information)

Owner: Phillip Wilson Domestic

If location corrected, was listed as:

Location changed to:

Section-Township-Range: _____

Fraction (¼ calls): SW SE

SW SE SW SE

Other changes: Initial statements: Lat./Long. incorrectly listed & more accurate location obtained. Casing diameter, type, and height not listed. Was casing pulled? was not answered.

Changed to: Accurate location, (39.8136321, -96.7571828). Casing type, limestone brick (3 ft diam.).
Approx 36 in. casing removed.

Comments: _____

Verification method: Confirmed information with Marshall County Conservation District.

Initials: BA Date: 6/25/25

Submitted by: ☐ Kansas Geological Survey, Data Resources Library, 1930 Constant Ave., Lawrence, KS 66047-3724
☒ Kansas Dept. of Health & Environment, Bureau of Water, 1000 SW Jackson, Suite 420, Topeka, KS 66612-1367

WATER WELL PLUGGING RECORD Form WWC-5P

KSA 82a-1212

ID NO.

1 LOCATION OF WATER WELL: County: Marshall	Fraction ¼ ¼ SW ¼ SE ¼	Section Number 4	Township Number T 3 S	Range Number 6 <input checked="" type="checkbox"/> E <input type="checkbox"/> W
--	---------------------------	---------------------	--------------------------	--

Street/Rural Address of Well Location; if unknown, distance & direction from nearest town or intersection: If at owner's address, check here ☐ Well is located at 360 Matador Rd, Marysville, KS.


Global Positioning Systems (GPS) information:

Latitude: -96.757 (in decimal degrees)
Longitude: 39.814 (in decimal degrees)
Elevation:
Horizontal Datum: ☐ WGS84, ☒ NAD83, ☐ NAD27
Collection Method:

2 WATER WELL OWNER: Phillip Wilson
RR#, St. Address, Box #: 326 Matador Rd
City, State ZIP Code: Marysville KS 66508

☒ GPS unit (Make/Model: Trimble 99133)
☐ Digital Map/Photo, ☐ Topographic Map, ☐ Land Survey
Est. Accuracy: ☐ < 3 m, ☐ 3-5 m, ☐ 5-15 m, ☐ > 15 m

3 MARK WELL'S LOCATION WITH AN "X" IN SECTION BOX:

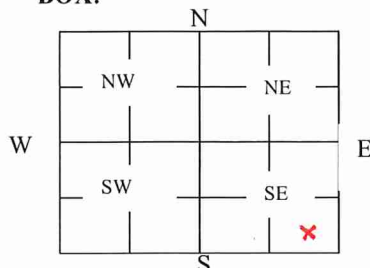

4 DEPTH OF WELL 53 ft.

WELL'S STATIC WATER LEVEL 43 ft

WELL WAS USED AS:

- | | | |
|--|---|---|
| <input checked="" type="checkbox"/> Domestic | <input type="checkbox"/> Public Water Supply | <input type="checkbox"/> Dewatering |
| <input type="checkbox"/> Irrigation | <input type="checkbox"/> Oil Field Water Supply | <input type="checkbox"/> Monitoring |
| <input type="checkbox"/> Feedlot | <input type="checkbox"/> Domestic (Lawn & Garden) | <input type="checkbox"/> Injection Well |
| <input type="checkbox"/> Industrial | <input type="checkbox"/> Air Conditioning | <input type="checkbox"/> Other |

Was a chemical/bacteriological sample submitted to Department? Yes ☐ No ☒

5 TYPE OF BLANK CASING USED:

- | | | | | |
|--------------------------------|-----------------------------------|--|--|--|
| <input type="checkbox"/> Steel | <input type="checkbox"/> RMP (SR) | <input type="checkbox"/> Wrought | <input type="checkbox"/> Fiberglass | <input type="checkbox"/> Other (Specify below) |
| <input type="checkbox"/> PVC | <input type="checkbox"/> ABS | <input type="checkbox"/> Asbestos-Cement | <input type="checkbox"/> Concrete Tile | |

Blank casing diameter _____ in. Was casing pulled? Yes ☐ No ☐ If yes, how much _____
Casing height above or below land surface _____ in.

6 GROUT PLUG MATERIAL: ☐ Neat cement ☐ Cement grout ☒ Bentonite ☐ Other

Grout Plug Intervals: From 4.5 ft. to 5 ft., From _____ ft. to _____ ft., From _____ ft. to _____ ft.

What is the nearest source of possible contamination:

- | | | | |
|---|--|---|--|
| <input type="checkbox"/> Septic tank | <input type="checkbox"/> Seepage pit | <input type="checkbox"/> Fuel storage | <input type="checkbox"/> Other (specify below) |
| <input type="checkbox"/> Sewer lines | <input type="checkbox"/> Pit privy | <input type="checkbox"/> Fertilizer storage | |
| <input type="checkbox"/> Watertight sewer lines | <input type="checkbox"/> Sewage lagoon | <input type="checkbox"/> Insecticide storage | |
| <input type="checkbox"/> Lateral lines | <input type="checkbox"/> Feedyard | <input type="checkbox"/> Abandoned water well | Direction from well? North |
| <input type="checkbox"/> Cess pool | <input checked="" type="checkbox"/> Livestock pens | <input type="checkbox"/> Oil well/Gas well | How many feet? 83 |

FROM	TO	PLUGGING MATERIALS	FROM	TO	PLUGGING MATERIALS
53	43	Sand & Chlorine			
43	5	Subsoil			
5	4.5	Bentonite			
4.5	0	Top Soil			

7 CONTRACTOR'S OR LANDOWNER'S CERTIFICATION: This water well was plugged under my jurisdiction and was completed on (mo/day/year) 4-22-2025 and this record is true to the best of my knowledge and belief. Kansas Water Well Contractor's License No. _____. This Water Well Record was completed on (mo/day/year) 5-14-2025 under the business name of Phillip Wilson by (signature) Phillip Wilson

Send one white copy to Kansas Department of Health & Environment, Geology Section, 1000 SW Jackson Street, Ste. 420, Topeka, KS 66612-1367. Send one copy to WATER WELL OWNER and retain one for your records.

Visit us at <http://www.kdheks.gov/waterwell/index.html> Telephone 785-296-5524.

KSA82a-1212

Revised 1/20/2015